


WELL PLUGGING RECORD

OR FORMATION PLUGGING RECORD

STATE OF KANSAS STATE CORPORATION COMMISSION Give All Information Completely Make Required Affidavit Mail or Deliver Report to: Conservation Division State Corporation Commission 800 Biting Building Wichita, Kansas

Strike out upper line when reporting plugging of formations.

Barton County. Sec. 17 Twp 20 Rge. 11 (E) (W) Location as "NE1/4NW1/4SW1/4" or footage from lines C N/2 SW SE Lease Owner Virginia Drilling Company, Inc. Lease Name Herter B Well No. 3 Office Address 701 Brown Bldg., Wichita 2, Kansas Character of Well (completed as Oil, Gas or Dry Hole) Date well completed 8-20 19 49 Application for plugging filed 8-20 19 49 Application for plugging approved 8-20 19 49 Plugging commenced 8-20 19 49 Plugging completed 8-20 19 49 Reason for abandonment of well or producing formation Dry hole If a producing well is abandoned, date of last production 19 Was permission obtained from the Conservation Division or its agents before plugging was commenced? YES

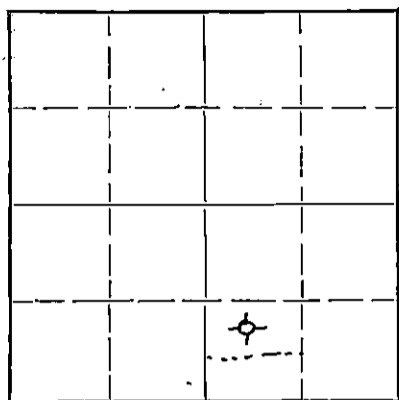

Locate well correctly on above Section Plat

Name of Conservation Agent who supervised plugging of this well C. D. Stough Producing formation Depth to top Bottom Total Depth of Well 3392 Feet Show depth and thickness of all water, oil and gas formations.

OIL, GAS OR WATER RECORDS

CASING RECORD

Table with 7 columns: Formation, Content, From, To, Size, Put In, Pulled Out. Row 1: 0, 134, 8-5/8, 134, none

Describe in detail the manner in which the well was plugged, indicating where the mud fluid was placed and the method or methods used in introducing it into the hole. If cement or other plugs were used, state the character of same and depth placed, from feet to feet for each plug set.

Filled hole with mud to 134 feet - set plug - run 15 sacks cement - filled hole with mud to 20 feet - run 10 sacks cement.

Handwritten stamps and signatures: AUG 24 1949 8-24-1949 STATE CORPORATION COMMISSION KANSAS

(If additional description is necessary, use BACK of this sheet)

Correspondence regarding this well should be addressed to Virginia Drilling Company, Inc. Address 701 Brown Bldg., Wichita 2, Kansas

STATE OF Kansas COUNTY OF Sedgwick S. A. Murphy (employee of owner) or (owner or operator) of the above-described well,


being first duly sworn on oath, says: That I have knowledge of the facts, statements, and matters herein contained and the log of the above-described well as filed and that the same are true and correct. So help me God.

(Signature) S. A. Murphy 701 Brown Bldg., Wichita 2, Kansas (Address)

SUBSCRIBED AND SWORN to before me this 23rd day of August, 1949

Handwritten signature of Notary Public

My commission expires February 5, 1953 22-2625 2-48-15M

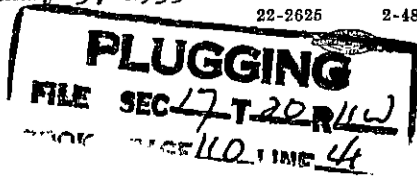

Name: Herter B No. 3
 Location: C N/2 SW SE Section 17-20-11, Barton County, Kansas
 Company: Virginia Drilling Company, Inc.
 Contractor: Virginia Drilling Company, Inc.
 Commenced: August 8, 1949
 Completed: August 20, 1949
 Elevation: 1775
 Total Depth: 3392

FORMATION	DEPTH	TOPS:	
Sand-clay	0-90	Heebner Shale	2939
Shale-shells	90-134	Brown Lime	3067
Blue shale	134-180	Lansing K. C.	3088
Shale	180-215	Conglomerate	3328
Red Bed	215-515		
Red Bed-shells	515-535	8-5/8" csg. set @ 134 134	
Anhydrite	535-580		
Shale-shells	580-1000		
Salt	1000-1070		
Salt-shale-shells	1070-1320		
Broken Lime	1320-1545		
Lime-shale	1545-1960		
Shale	1960-2100		
Shale-lime	2100-2700		
Shale	2700-2745		
Lime	2745-3000		
Shale	3000-3065		
Lime	3065-3392		

Now comes S. A. Murphy, who states that he is familiar with the drilling of oil and gas wells and knows of his own knowledge that the Herter B No. 3, located in the Center of the N/2 SW SE Section 17-20-11, Barton County, Kansas was drilled to a total depth of 3392 feet. Same was plugged and abandoned.

Subscribed and sworn to before me this 23rd day of August, 1949.

Murphy
 Notary Public

My commission expires February 5, 1953.

RECEIVED

COMM. NO. 1000

AUG 24 1949

STATE CORPORATION
 COMMISSION
 KANSAS

