


Give All Information Completely
Make Required Affidavit
Mail or Deliver Report to:
Conservation Division
State Corporation Commission
212 North Market Insurance Bldg.
Wichita, Kansas

WELL PLUGGING RECORD

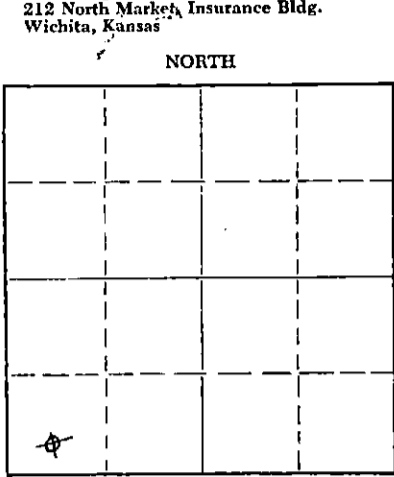

Barton County, Sec. 17 Twp. 20s Rge. 11W (E) (W)
Location as "NE/CNW%SW%" or footage from lines. S₂ SW₄
Lease Owner Virginia Drilling Company
Lease Name Selle Well No. # 5
Office Address 1115 16th, Great Bend, Kansas
Character of Well (completed as Oil, Gas or Dry Hole) _____
Date well completed _____ 19____
Application for plugging filed yes 19____
Application for plugging approved yes 19____
Plugging commenced 5-18-60 19____
Plugging completed 5-22-60 19____
Reason for abandonment of well or producing formation _____

If a producing well is abandoned, date of last production _____ 19____
Was permission obtained from the Conservation Division or its agents before plugging was commenced? yes

Name of Conservation Agent who supervised plugging of this well Donald Truan
Producing formation _____ Depth to top _____ Bottom _____ Total Depth of Well 3120' Feet
Show depth and thickness of all water, oil and gas formations.

OIL, GAS OR WATER RECORDS

CASING RECORD

FORMATION	CONTENT	FROM	TO	SIZE	PUT IN	PULLED OUT
				5 1/2"		2642'

Describe in detail the manner in which the well was plugged, indicating where the mud fluid was placed and the method or methods used in introducing it into the hole. If cement or other plugs were used, state the character of same and depth placed, from _____ feet to _____ feet for each plug set.

Plugging commenced 5-18-60. Plugging completed 5-22-60. Measured into total depth, 3120'. Spudded out bridge at 2054'. Worked and shot casing. Shot 5 1/2" casing at 2642'. Worked pipe free. Pulled and laid down casing. Squeezed the well with 15 sacks of mud and 75 sacks of cement. Measured into hole and found cement at 45'. Mudded hole and capped the well with 3 sacks of cement.

6-8-1960
RECEIVED
STATE CORPORATION COMMISSION
JUN 8 1960
CONSERVATION DIVISION
Wichita, Kansas

(If additional description is necessary, use BACK of this sheet)

Name of Plugging Contractor J. O. Forbes d/b/a Forbes Casing Pulling Company
Address Box 221 Great Bend, Kansas

STATE OF Kansas, COUNTY OF Barton, ss.
J. O. Forbes (employee of owner) or (owner or operator) of the above-described well, being first duly sworn on oath, says: That I have knowledge of the facts, statements, and matters herein contained and the log of the above-described well as filed and that the same are true and correct. So help me God.

(Signature) J. O. Forbes
Box 221, Great Bend, Kansas
(Address)

SUBSCRIBED AND SWORN TO before me this 23rd day of May, 19 60.

December 8th, 1963
My commission expires _____
Kayann Jenkins Notary Public.

15.009.19524.0000

WELL #5 - C S/2 SW SW/4 Sec. 17-20-11 Barton County, Kansas
Company - Virginia Drlg Co Inc.
Contractor - same
Commenced - November 27, 1959
Completed - Rotary hole - Dec. 8, 1959
Completed Cable tools - Febr. 19, 1960
Elevation - 1783 KB
Total Rotary depth - 3296
Total Cable Tools - 3305

8 5/8" - at 213 w/175 sx cem.
5 1/2" at 3294 w/100 sx cem.
Pulled 2642' 5 1/2"
Plugged and abandoned - May 22, 1960

FORMATION	DEPTH
Surface-sand	0- 35
Gravel	35- 55
Shale-shells	55- 270
Red bed	270- 620
Anhydrite	620- 650
Shale-shells	650- 680
Shale-shells-salt	680-1110
Shale-shells	1110-1335
Lime-shale	1335-2190
Shale - brkn lime	2190-2380
Lime-shale	2380-2505
Shale-shells	2505-2575
Lime-shale	2575-2715
Lime	2715-2795
Lime-shale	2795-2845
Lime	2845-2895
Lime-shale	2895-3035
Lime	3035-3039
Brn lime	3039-3055
Lime	3055-3225
Lime-shale	3225-3262
Lime	3262-3296 Rot. TD
	3305- Cable TD

- TOPS:
- 520 - Anhydrite
 - 2912 - Heebner Shale
 - 2927 - Toronto lime
 - 2943 - Douglass shale
 - 3039 - Iatan lime
 - 3055 - Lansing
 - 3282 - Detrital zone
 - 3294 - Arbuckle

RECEIVED
STATE CORPORATION COMMISSION

JUN 8 1960

CONSERVATION DIVISION
Wichita, Kansas

Murlee Hawkins
Murlee Hawkins

Subscribed and sworn to before me, a Notary Public,
this 7th day of June, 1960.

Jess M. Underwood
Notary Public

My commission expires: March 15, 1962