


Give All Information Completely  
Make Required Affidavit  
Mail or Deliver Report to:  
Conservation Division  
State Corporation Commission  
211 No. Broadway  
Wichita, Kansas

WELL PLUGGING RECORD

Barton County, Sec. 17 Twp. 20 Rge. 11 (E) (W) X

Location as "NE/CNW/SW" or footage from lines SW SW  
Lease Owner Virginia Drlg. Co., Inc.  
Lease Name Selle Well No. 2  
Office Address 712 Brown Bldg.-Wichita 2, Kansas  
Character of Well (completed as Oil, Gas or Dry Hole) Oil then dry  
Date well completed November 13, 1947 19  
Application for plugging filed June 13, 1957 19  
Application for plugging approved 2 " " 19  
Plugging commenced June 16, 1957 19  
Plugging completed June 19, 1957 19  
Reason for abandonment of well or producing formation no more oil

NORTH

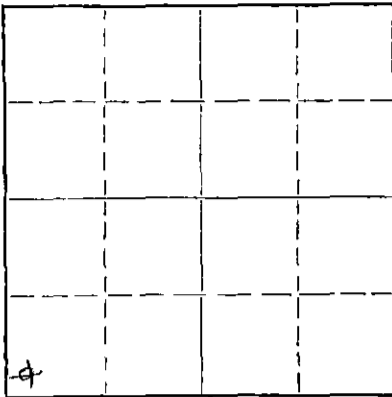

Locate well correctly on above  
Section Plat

If a producing well is abandoned, date of last production April 10, 1957 19  
Was permission obtained from the Conservation Division or its agents before plugging was commenced? yes

Name of Conservation Agent who supervised plugging of this well R. M. Brundage, Hoisington, Kansas  
Producing formation Arbuckle Depth to top 3288 Bottom 3400- Total Depth of Well 3400 Feet  
Show depth and thickness of all water, oil and gas formations. before plug back to 3330

OIL, GAS OR WATER RECORDS

CASING RECORD

FORMATION	CONTENT	FRDM	TD	SIZE	PUT IN	PULLED OUT
		0	130	10 3/4"	130 ft.	none
			3288	5 1/2"	3288 1/2	1837 ft.

Describe in detail the manner in which the well was plugged, indicating where the mud fluid was placed and the method or methods used in introducing it into the hole. If cement or other plugs were used, state the character of same and depth placed, from \_\_\_\_\_ feet to \_\_\_\_\_ feet for each plug set.

Mudded - 3250 ft to 220 ft.  
Rock bridge - 220 ft to 200 ft.  
40 sx cmenet - 200 to 160 ft.  
Mudded - 160 ft. to 20 ft.  
5 sx cement - 20 ft to cellar

7-8-1957

CONSERVATION DIVISION  
Wichita, Kansas

(If additional description is necessary, use BACK of this sheet)  
Name of Plugging Contractor R & S Pipe Pulling Co.  
Address Box 192 @ Ellinwood, Kansas

STATE OF Kansas, COUNTY OF Sedgwick, ss.  
S. A. Murphy (employee of owner) or (owner or operator) of the above-described well, being first duly sworn on oath, says: That I have knowledge of the facts, statements, and matters herein contained and the log of the above-described well as filed and that the same are true and correct. So help me God.

(Signature) S. A. Murphy  
712 Brown Bldg-Wichita 2, Kansas  
(Address)

SUBSCRIBED AND SWORN to before me this 1st day of July, 19 57

My commission expires Febr. 5, 1961.

Madee Hawk  
Notary Public.

PLUGGING  
FILE SEC. 17 T. 20 R. 11W  
BOOK PAGE 20 LINE 3

15.009.14590.0000

Selle # 2 - SW SW/4 Section 17-20-11 Barton Co., Kansas  
 Company - Virginia Drlg. Co., Inc.  
 Commenced - September 30, 1941  
 Completed November 13, 1941  
 Contractor - Virginia Drlg. Co. Inc.  
 Total rotary depth 3290 - final depth 3400 ft.

FORMATION	DEPTH	FORMATION	DEPTH
Sand	0- 90	Lime	3203-3310
Shale & Shells	90- 150	Sand	3310-3318
Rammed to 130' - set 130' of		Wh lime	3318-3351½
10 3/4" surface.		Shale	3351½-3353
Sahle - rebed-shale	150- 495	Lime	3353-3357½
Shale	495- 520	Shale	3357½-3380
Anhydrite	520-1000	Lime	3380-3396
Salt-shells	1000-1032	Hd lime	3396-3397½
Salt-shale-shells	1032-1272	Lime	3397½-3400
Shale - lime	1272-1484		plug back to 3330 ft.
Lime broken	1484-1590		
Lime-shale brks	1590-1645		
Lime	1645-1686		
Lime-shale	1686-1820		
Shale	1820-1869		
Lime	1869-1940		
Shale & lime shells	1940-1970		
Lime brkn	1970-2046		
Shale	2046-2060		
Lime	2060-2080		
Shale-lime	2080-2235		
Shale-shells	2235-2285		
Shale	2285-2350		
Lime	2350-2370		
Shale	2370-2413		
Lime shale	2413-2485		
Lime	2485-2570		
Brkn lime	2570-2608		
Lime-shale	2608-2660		
Lime	2660-2884		
Lime-shale	2884-2916		
Lime-shale brks	2916-2942		
Shale	2942-3075		
Lime K C	3075-3115		
Lime-shale streaks	3115-3174		
Lime-bottom KC	3174-3197		
Shale brk	3197-3203		

RECEIVED  
 STATE CORPORATION COMMISSION

JUL 8 - 1957

CONSERVATION DIVISION  
 Wichita, Kansas

PLUGGING  
 FILE SEC. 17. T. 20. R. 11W  
 BOOK PAGE 20 LINE 3

*S. A. Murphy*  
 S. A. Murphy

Subscribed and sworn to before me, a Notary Public, this  
 6th day of July, 1957

*Murlee Hawkins*  
 Notary Public - Murlee Hawkins

My commission expires: Febr. 5, 1961.