


WELL PLUGGING RECORD

Give All Information Completely
Make Required Affidavit
Mail or Deliver Report to:
Conservation Division
State Corporation Commission
814 Bitting Building
Wichita, Kansas

Barton County, Sec. 17 Twp. 20 Rge. 11 (E) (W)

Location as "NE/CNW&SW" or footage from lines SW NE SE
Lease Owner Virginia Drlg. Co Inc.
Lease Name Herter B Well No. 2
Office Address 701 Brown Bldg., Wichita 2, Kansas
Character of Well (completed as Oil, Gas or Dry Hole) Dry
Date well completed Jan. 13, 1948 - cable tool drlg in. 19
Application for plugging filed July 14, 1954 19
Application for plugging approved July 14, 1954 19
Plugging commenced July 19, 1954 19
Plugging completed July 19, 1954 19
Reason for abandonment of well or producing formation Dry

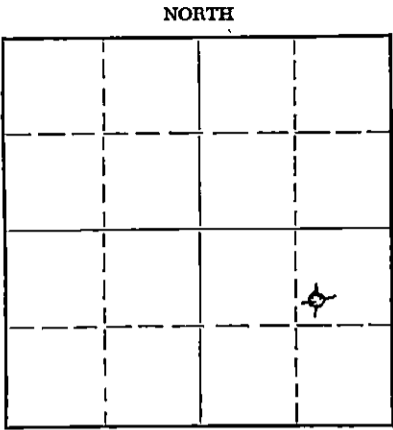

Locate well correctly on above Section Plat

If a producing well is abandoned, date of last production June 1, 1954 19
Was permission obtained from the Conservation Division or its agents before plugging was commenced? yes

Name of Conservation Agent who supervised plugging of this well Warren H. Horner
Producing formation Arbuckle Depth to top 3304 Bottom 3352 Total Depth of Well 3352 Feet
Show depth and thickness of all water, oil and gas formations.

OIL, GAS OR WATER RECORDS

CASING RECORD

FORMATION	CONTENT	FROM	TO	SIZE	PUT IN	PULLED OUT
		0	116	8 5/8"	116	none
			3305	5 1/2"	3333' 11"	1905'

Describe in detail the manner in which the well was plugged, indicating where the mud fluid was placed and the method or methods used in introducing it into the hole. If cement or other plugs were used, state the character of same and depth placed, from _____ feet to _____ feet for each plug set.

Mudded to 3150
Sand bridge - 3150 - 3125
5 sx cement - 3125-3100
Surface hole squeezed w/ 20 sx mud - & 80 sx cement by Halliburton

RECEIVED
STATE CORPORATION COMMISSION
JUL 27 1954
7-27-1954
CONSERVATION DIVISION
Wichita, Kansas

(If additional description is necessary, use BACK of this sheet)
Name of Plugging Contractor R & S Pipe Pulling Co.
Address Ellinwood, Kansas

STATE OF Kansas, COUNTY OF Sedwick, ss.
S. A. Murphy (employee of owner) or (owner or operator) of the above-described well, being first duly sworn on oath, says: That I have knowledge of the facts, statements, and matters herein contained and the log of the above-described well as filed and that the same are true and correct. So help me God.

(Signature) S. A. Murphy
701 Brown Bldg., Wichita 2, Kansas
(Address)

SUBSCRIBED AND SWORN to before me this 26th day of July, 19 54

Mrs. Mable Hawkins
Notary Public.

My commission expires February 5, 1957.

PLUGGING
FILE SEC 17 T 20 R 11 W
BOOK PAGE 48 LINE 25

Well: Herter "B" #2
 Location: SW/cor. NE SE Section 17-20S-11W, Barton County, Kansas
 Company: Virginia Drilling Company, Inc.
 Contractor: Virginia Drilling Company, Inc.
 Commenced: August 21, 1947
 Completed: RTD September 20, 1947 *C. Tools - Jan. 13, 1948*
 Total Depth: 3330
 Elevation: 1777

FORMATION	DEPTH	TOPS:
Sand & Gravel	0-70	Arbuckle 3298
Sand	70-90	
Slate	90-99	Circulated @ 3165 - 1 1/2 hrs.
Red chert	99-104	@ 3304 - 1 1/2 hr.
Shale-shells	104-117	@ 3313 - 1 1/2 hr.
Shale-shells	117-530	@ 3319 - 1 1/2 hr.
Anhydrite	530-560	
Red bed & shells	560-600	
Shells-shale	600-1245	
Shale-salt-shells	1245-1400	
Shells-shale	1400-1487	
Lime	1487-1560	
Lime-shale	1560-1703	
Lime	1703-1805	Set 8 5/8" csg. @ 116'
Lime-shale	1805-1875	
Lime-shale	1875-1926	Set 5 1/2" csg. @ 3305
Lime	1926-1950	
Shale-lime	1950-2198	
Shale-lime	2198-2315	
Shale-shells	2315-2450	
Shale-broken lime	2450-2524	
Shale	2524-2564	
Shale-lime	2564-2752	
Lime	2752-2925	
Lime-shale	2925-2980	
Shale-lime	3040-3085	
Lime	3085-3130	
Lime-shale	3130-3290	
Lime	3290-3319	
Arbuckle Lime	3319-3330 RTD	

Now comes S. A. Murphy, who states that he is familiar with the drilling of oil and gas wells and known of his own knowledge that the Herter "B" #2, located in the SW/cor. NE SE Section 17-20 S-11W, Barton County, Kansas, was drilled to a total depth of 3330 feet.

S. A. Murphy

Subscribed and sworn to before me, a Notary public, this 25th day of February, 1948.

Marble Gawlin
 Notary Public

My commission expires: February 5, 1949.

RECEIVED
 STATE COMMISSION
 CONSERVATION DIVISION

PLUGGING
 FILE SEC. 17-20 S-11W
 BOOK PAGE 47 LINE 25

Header B2 - SW NE SE Section 17-20-11 Barton County, Kansas
Company - Virginia Drlg Co Inc.

Additional drilling June 1954 -

FORMATION	DEPTH
3330-52 Shale & lime	
3331-35 Hard Lime	
3335-37 Lime-vbrn shale	
3337-48 Shale & chert	
3348-52 - Shale-lime	
3352 TD. Hole full water	

S. A. Murphy

S. A. Murphy

Subscribed and sworn to before me, a Notary Public, this
26th day of July, 1954.

W. M. Sawkins

Notary Public

My commission expires: Feb. 5, 1957

RECEIVED
THE CORPORATION COMMISSION
JUL 27 1954
REGISTRATION DIVISION
