

STATE OF KANSAS  
STATE CORPORATION COMMISSION

WELL PLUGGING RECORD


OR

FORMATION PLUGGING RECORD

Strike out upper line  
when reporting plug-  
ging off formations.

Give All Information Completely  
Make Required Affidavit  
Mail or Deliver Report to:  
Conservation Division  
State Corporation Commission  
800 Bittling Building  
Wichita, Kansas

NORTH

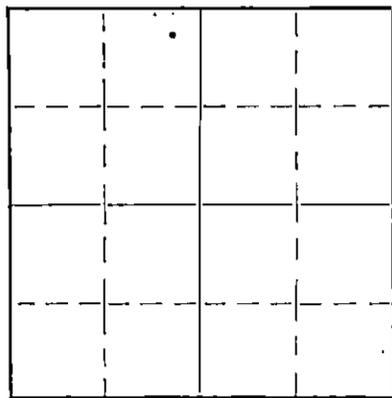

Locate well correctly on above  
Section Plat

Barton County. Sec. 19 Twp. 20 Rge. (E) 11 (W)

Location as "NE 1/4 NW 1/4 SW 1/4" or footage from lines NE Corner NW/4

Lease Owner Hollow Drilling Company, Inc.,

Lease Name Andreae Well No. 2

Office Address Inman, Kansas

Character of Well (Completed as Oil, Gas or Dry Hole) Dry Hole

Date, well completed 6-24- 193 9

Application for plugging filed 6-24 193 9

Application for plugging approved 6-24 193 9

Plugging Commenced 6-24 193 9

Plugging Completed 6-24 193 9

Reason for abandonment of well or producing formation extremely low well

no oil or gas found.

If a producing well is abandoned, date of last production dry hole 193

Was permission obtained from the Conservation Division or its agents before plugging was com-  
menced? yes

Name of Conservation Agent who supervised plugging of this well C. T. Alexander.

Producing formation..... Depth to top..... Bottom..... Total Depth of Well 3370 Feet.

Show depth and thickness of all water, oil and gas formations.

OIL, GAS OR WATER RECORDS



CASING RECORD

Formation	Content	From	To	Size	Put In	Pulled Out
<u>log enclosed.</u>				<u>8 5/8"</u>	<u>232</u>	<u>Left in-- cemented with 200 sacks.</u>

Describe in detail the manner in which the well was plugged, indicating where the mud fluid was placed and the method or methods used in introducing it into the hole. If cement or other plugs were used, state the character of same and depth placed, from..... feet to..... feet for each plug set.

The well was drilled with rotary tools--surface pipe, 8 5/8" set at 232' and cemented with 200 sacks cement--the hole was filled with extremely heavy mud through the drill stem, pipe being placed on bottom and then as the hole was filled the drill stem was removed at intervals to insure complete mudding from the total depth to the base of the surface casing--a wood tapered plug was driven in the base of the surface casing and 10 sacks of cement placed upon this plug through the drill stem--surface casing was then filled with extremely heavy mud to top--the top of surface casing was welded shut 5' below the surface of the ground and the cellar filled with top soil.

6-27-1939

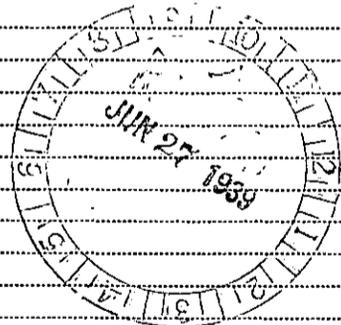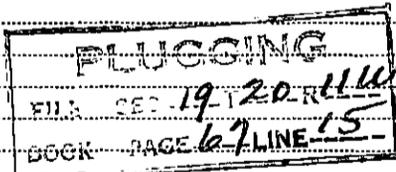

(If additional description is necessary, use BACK of this sheet)

Correspondence regarding this well should be addressed to Hollow Drilling Company, Inc.,

Address Inman, Ks.

STATE OF Kansas, COUNTY OF McPherson, ss.

F. H. Hollow (employee of owner) or (owner or operator) of the above-described well, being first duly sworn on oath, says: That I have knowledge of the facts, statements, and matters herein contained and the log of the above-described well as filed and that the same are true and correct. So help me God.

(Signature) [Handwritten Signature]

(Address)

SUBSCRIBED AND SWORN to before me this 24th day of June, 1939.

My commission expires Sept 15 1942

[Handwritten Signature]  
Notary Public.

WELL--ANDREAE #2, 440' West of East Line 440'  
south of North Line, NW/4 Section 19-  
20a-11w, Barton County, Kansas.

Date Commenced: 6-5-1939.

Date Completed: 6-24-1939.

Contractor: Hollow Drilling Co., Inc.,  
Inman, Kansas.

Tools: Rotary.

Casing Record:

8 1/2" 252 Feet--cemented with  
200 sacks--left in.

Log.

0	150	Sand
150	157	Shale Blue
157	232	Sand & Shale
232	528	Red Rock
528	558	Anhydriate Lime
558	751	Shale & Shells
751	930	Lime & Shale
930	1045	Shale & Shells
1045	1539	Salt & Shells
1330	1380	Lime
1380	1466	Shale
1466	1528	Lime
1528	1605	Shells & Shale
1605	1804	Shale & Lime
1804	1862	Lime
1862	1882	Sticky Blue Shale
1882	1900	Lime
1900	1910	Shale
1910	1920	Lime
1920	1955	Lime
1955	1965	Broken Lime
1965	1970	Shale
1970	1985	Lime
1985	2025	Broken Lime
2025	2030	Lime
2030	2069	Lime & Shale Breaks
2069	2097	Lime
2097	2120	Lime
2120	2130	Broken Lime
2130	2149	Lime
2149	2192	Lime & Shale
2192	2205	Shale
2205	2211	Lime
2211	2224	Lime & Shale
2224	2375	Shale & Shells
2375	2435	Shale & Lime
2435	2455	Lime
2455	2650	Shale & Shells
2650	2640	Lime
2640	2665	Shale & Shells
2665	2679	Lime
2679	2681	Shale
2681	2690	Shale & Shells
2690	2915	Topeka Lime
2915	2967	Lime & Shale
2967	3005	Lime
3005	3055	Lime & Shale
3055	3078	Shale & Shells
3078	3090	Lime
3090	3311	KC Lime
3311	3370	Conglomerate/ T.D.
3370		Dry and Abandoned.

