


WELL PLUGGING RECORD

Give All Information Completely
Make Required Affidavit
Mail or Deliver Report to:
Conservation Division
State Corporation Commission
800 Bitting Building
Wichita, Kansas

NORTH

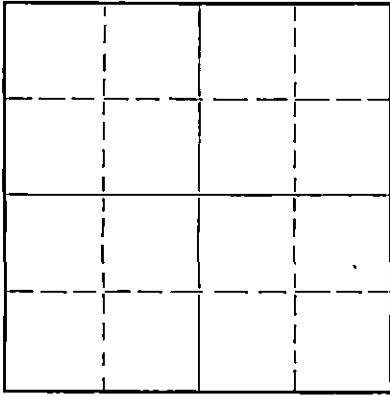

Locate well correctly on above
Section Plat

Barton County. Sec. 21 Twp. 20 Rge. (E) 11 (W)
Location as "NE/CNW $\frac{1}{4}$ SW $\frac{1}{4}$ " or footage from lines NE NE NE
Lease Owner F. G. Holl
Lease Name Hagen Well No. 1
Office Address 6427 East Kellogg Wichita, Kansas
Character of Well (completed as Oil, Gas or Dry Hole) Oil
Date well completed 3-29-51 19...
Application for plugging filed 19...
Application for plugging approved November 21 19 66
Plugging commenced 19...
Plugging completed 19...
Reason for abandonment of well or producing formation not producing
If a producing well is abandoned, date of last production 19...
Was permission obtained from the Conservation Division or its agents before plugging was commenced? yes

Name of Conservation Agent who supervised plugging of this well Donald Truan
Producing formation Arbuckle Depth to top 3255 Bottom 3258 Total Depth of Well 3299 Feet
Show depth and thickness of all water, oil and gas formations.

OIL, GAS OR WATER RECORDS

CASING RECORD

Formation	Content	From	To	Size	Put In	Pulled Out
				8 5/8	277'	-0-
				5 1/2	3296'	1195'

Describe in detail the manner in which the well was plugged, indicating where the mud fluid was placed and the method or methods used in introducing it into the hole. If cement or other plugs were used, state the character of same and depth placed, from... feet to... feet for each plug set.

Halliburton 5 1/2" plug set at 3240' with rock bridge on top. Dumped 5 sacks cement with dump bailer. Shot pipe off at 1195'. Recovered same. Bailed fluid down to 260. Pushed Halliburton 8 5/8. Rock bridge. Dumped 25 sacks cement. Filled hole to 40' with mud. Put Halliburton 8 5/8" plug. Rock bridge 10 sacks cement. Cement to top of 8 5/8 surface.

RECEIVED
STATE CORPORATION COMMISSION
DEC 6 1966
12-6-1966
CONSERVATION DIVISION
Wichita, Kansas

(If additional description is necessary, use BACK of this sheet)

Correspondence regarding this well should be addressed to F. G. Holl
Address 6427 East Kellogg Wichita 7, Kansas

STATE OF KANSAS, COUNTY OF SEDGWICK, ss.
F. G. Holl (and as owner) or (owner or operator) of the above-described well, being first duly sworn on oath, says: That I have knowledge of the facts, statements, and matters herein contained and the log of the above-described well as filed and that the same are true and correct. So help me God.

(Signature) [Signature]
6427 East Kellogg Wichita, Kansas
(Address)

SUBSCRIBED AND SWORN TO before me this 5th day of December, 19 66.

My commission expires February 1, 1970
Notary Public.

15.009.14625.0000

ATLAS DRILLING COMPANY, INC.
220 Randall Bldg.
Newton, Kansas

Date March 30, 1951

WELL LOG

LEASE: Hagan

LOCATION: 21-20-11W
NE NE NE
Barton County

WELL NO. #1

OPERATOR: F. G. Holl
822 Central Bldg.
Wichita, Kans.

Date Commenced 3-18-51
Date Completed 3-29-51

CONTRACTORS:
Atlas Drilling Co., Inc.
220 Randall Bldg.
Newton, Kansas

REMARKS: Ran 9 joints of 3 5/8"
casing @ 277 ft.,
cemented w/200 sacks
cement & 100 # calcium
chloride.

<u>From</u>	<u>To</u>	<u>Formation</u>
0	120	Sand
120	215	Shale
215	255	Red Bed
255	350	Shale & Shell
350	500	Red Bed & Rock
500	535	Anhydurate
535	1475	Shale & Shell
1475	1565	Shale & Lime
1565	1604	Lime
1604	2000	Shale & Lime
2000	2405	Shale
2405	2752	Shale & Lime
2752	2903	Lime
2903	3042	Shale & Lime
3042	3299	Lime
3299		Total Depth

RECEIVED
STATE CORPORATION COMMISSION

NOV 21 1966

CONSERVATION DIVISION
Wichita, Kansas

I hereby certify that the foregoing is a true and correct copy of the Well Log for the Hagan No. 1 drilled for F. G. Holl, - 822 Central Bldg., Wichita, and completed March 29 1951 Kansas

ATLAS DRILLING COMPANY, INC.

James G. Gould
James G. Gould Sec. - Treas.

STATE OF KANSAS)
) ss.
COUNTY OF HARVEY)

SUBSCRIBED AND SWORN TO, Before the undersigned, A Notary Public, in and for the County and State aforesaid this 3 day of March, 1951.

My commission expires 19

Grady Carnahan
Notary Public

