

STATE OF KANSAS
STATE CORPORATION COMMISSION


Give All Information Completely
Make Required Affidavit
Mail or Deliver Report to:
Conservation Division
State Corporation Commission
211 No. Broadway
Wichita, Kansas

WELL PLUGGING RECORD

Barton County. Sec. 21 Twp. 20 Rge. 11 (E) W (W)

Location as "NE/CNW/SW" or footage from lines _____
Lease Owner L. K. Parrish
Lease Name Meggers #1 Well No. 1
Office Address 714 Fourth National Bank Bldg., Wichita, Ks.
Character of Well (completed as Oil, Gas or Dry Hole) Oil
Date well completed _____ 19____
Application for plugging filed _____ 19____
Application for plugging approved _____ 19____
Plugging commenced Oct. 1 1962
Plugging completed Oct. 8 1962
Reason for abandonment of well or producing formation Depleted

NORTH

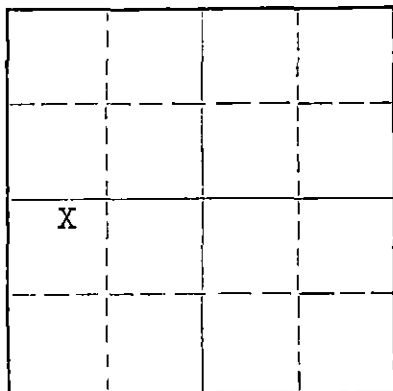

Locate well correctly on above
Section Plat

If a producing well is abandoned, date of last production _____ 19____
Was permission obtained from the Conservation Division or its agents before plugging was commenced? Yes

Name of Conservation Agent who supervised plugging of this well Don Truant
Producing formation _____ Depth to top _____ Bottom _____ Total Depth of Well 3300 Feet
Show depth and thickness of all water, oil and gas formations.

OIL, GAS OR WATER RECORDS

CASING RECORD

FORMATION	CONTENT	FROM	TO	SIZE	PUT IN	PULLED OUT
				8 5/8"	215	None
				5 1/2"	3300	2450

Describe in detail the manner in which the well was plugged, indicating where the mud fluid was placed and the method or methods used in introducing it into the hole. If cement or other plugs were used, state the character of same and depth placed, from _____ feet to _____ feet for each plug set.

08
Plugged at 3240 with 10' rock and 5 sacks cement
Filled with mud to 200'
Placed rock bridge at 190'
Dumped 1 sack of Cal Seal and 1 sack of cement
Bailed hole and dumped 25 sacks of cement
Bridged at 30'
Dumped 10 sacks of cement as cap

RECEIVED
STATE CORPORATION COMMISSION

OCT 12 1962

CONSERVATION DIVISION
Wichita, Kansas

10-12-1962

(If additional description is necessary, use BACK of this sheet)
Name of Plugging Contractor PIPE PULLERS INC.
Address Box 486, Ellinwood, Kansas

STATE OF Kansas COUNTY OF Dedrick, ss.
L. K. Parrish (employee-of-owner) or (owner or operator) of the above-described well, being first duly sworn on oath, says: That I have knowledge of the facts, statements, and matters herein contained and the log of the above-described well as filed and that the same are true and correct. So help me God.

(Signature) L. K. Parrish
714-4TH NTL. BANK BLDG. (Address)
WICHITA, KAN.

SUBSCRIBED AND SWORN TO before me this 10th day of October, 1962

My commission expires Oct 13, 1964
Lorraine M. Johnson Notary Public.



COPY


WELL LOG BUREAU—KANSAS GEOLOGICAL SOCIETY
 508 East Murdock, Wichita, Kansas

Company. L. K. FARRISH
 Farm- Meggers No. 1

SEC. 21 T. 20 R. 11W
 SE NW SW

Total Depth. 3338'
 Comm. 7-23-55 Comp. 7-31-55
 Shot or Treated.
 Contractor. Garvey Hrlg. Co.
 Issued. 6-20-59

County Barton
 KANSAS

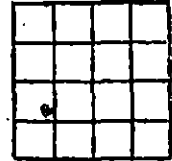

CASING:
 8 5/8" 215' cem w/175 sx.
 5 1/2" 3300' cem w/100 sx.

Elevation. 1784' DE

Production. 12 BOPD

Figures Indicate Bottom of Formations.

surface soil & sand 130
 shale & shells 230
 red bed 530
 Anhydrite 555
 shale & shells 1490
 lime 1545
 lime & shale 1920
 lime 1980
 shale 2095
 shale & lime 2530
 lime & shale 2985
 shale & lime 3095
 lime 3338
 Total Depth

TOPS: SCOUT
 Heebner 2943
 Brown Lime 3072
 Lansing 3089
 Arbuckle 3326

RECEIVED
 STATE CORPORATION COMMISSION

OCT 12 1962

CONSERVATION DIVISION
 Wichita, Kansas