


WELL PLUGGING RECORD

Give All Information Completely
Make Required Affidavit
Mail or Deliver Report to:
Conservation Division
State Corporation Commission
211 No. Broadway
Wichita, Kansas

Barton County, Sec. 12 Twp. 20 Rge. (E) 12 (W)

Location as "NE/CNW/SW" or footage from lines NE - NW
Lease Owner Quality Supply Co., Inc.
Lease Name M. Scharz Well No. 1
Office Address 202 Petroleum Bldg, Wichita, Kansas
Character of Well (completed as Oil, Gas or Dry Hole) _____
Date well completed _____ 19____
Application for plugging filed _____ 19____
Application for plugging approved _____ 19____
Plugging commenced _____ 5-16 19 61
Plugging completed _____ 5-23 19 61
Reason for abandonment of well or producing formation _____

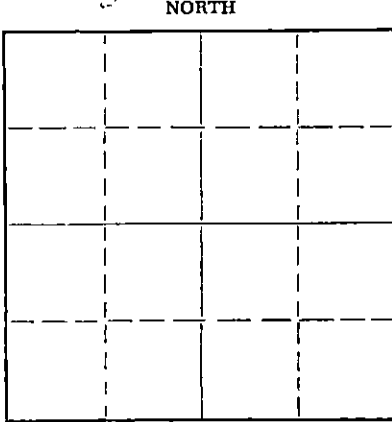

Locate well correctly on above Section Plat

If a producing well is abandoned, date of last production _____ 19____
Was permission obtained from the Conservation Division or its agents before plugging was commenced? Yes

Name of Conservation Agent who supervised plugging of this well Donald Truan
Producing formation _____ Depth to top _____ Bottom _____ Total Depth of Well 3349 Feet
Show depth and thickness of all water, oil and gas formations.

OIL, GAS OR WATER RECORDS

CASING RECORD

FORMATION	CONTENT	FROM	TO	SIZE	PUT IN	PULLED OUT
				8 5/8	218'	None
				5 1/2"	3346'	2700'

Describe in detail the manner in which the well was plugged, indicating where the mud fluid was placed and the method or methods used in introducing it into the hole. If cement or other plugs were used, state the character of same and depth placed, from _____ feet to _____ feet for each plug set.

Plug @ 3150'
Top Perforation 3102'

Sanded to 3070' - dumped 5 sks cement - pulled casing - mudded hole, - tried to bail fluid down - set plug at 210' - dumped 1 sk Cal Seal - Dumped another sk Cal Seal on plug - bailed fluid down - dumped 25 sks cement - mudded to 35' - set 5' rock bridge - dumped 10 sks cement

RECEIVED
STATE CORPORATION COMMISSION

6-5-61 JUN 5 1961

CONSERVATION DIVISION
Wichita, Kansas
License # 236

(If additional description is necessary, use BACK of this sheet)
Name of Plugging Contractor R & D Casing Pulling Co.
Address Box 572, Hutchinson, Kansas

STATE OF Kansas, COUNTY OF Sedgwick, ss.
Jack Shear (Employee of owner) or (owner or operator) of the above-described well, being first duly sworn on oath, says: That I have knowledge of the facts, statements, and matters herein contained and the log of the above-described well as filed and that the same are true and correct. So help me/ God.

(Signature) Jack Shear, President
214 Petroleum Bldg.
(Address)

SUBSCRIBED AND SWORN TO before me this 5th day of June, 1961

My commission expires June 1, 1963
Lee Markin Notary Public.

CONTRACTOR'S VERIFIED LOG

Operator Sohio Petroleum Company Farm Name Schartz Well No. #1

Location C-NE/4 NE/4 NW/4 SW/4 Section 12-20-12W

Pool Name Silica County Barton State Kansas

Commencement Date April 23, 1947 Completion Date May 7, 1947

LOG OF WELL

Depth		Formation	Deviation from Vertical (Degrees)	Remarks
From	To			
		Surface Dirt & Sand	60	
		Sand	90	
		Shale & Lime Shells	218	
		Shale & Lime Shells	356	
		Red Bed	570	
		Lime	582	
		Shale, Red Bed & Shells	685	
		Shale & shells	870	
		Red, Bed, salt & shale	1220	
		Shale & Shells	1360	
		Lime & Shale	1445	
		Lime, shells & shale	1520	
		Lime	1600	
		Lime & shale	1660	
		Sandy Lime	1725	
		Shale & Lime	2155	
		Shale Bro. Lime	2215	
		Shale & Lime	2480	
		Shale & Shells	2565	
		Lime & Shale	2775	
		Lime	2915	
		Lime & Shale	3025	
		Shale & Shells	3087	
		Lime	3165	
		Lime & Shale	3191	
		Lime	3239	
		Lime & Shale	3290	
		Lime	3334	
		Arbuckle	3351	T.D. Rotary Bushing
<u>Derrick Floor Measurements</u>				
		Arbuckle Top	3342	
		T.D.	3349	
		K.C. Top	3102	
		K.C. Sat.	3102-12	
		Cong.	3337-42	

RECEIVED
STATE CORPORATION COMMISSION
JUN 5 1961
CONSERVATION DIVISION
Wichita, Kansas

RECEIVED
JUN 23 1947

SOHIO PETROLEUM COMPANY
RUSSELL, KANSAS

