

STATE OF KANSAS  
STATE CORPORATION COMMISSION

WELL PLUGGING RECORD

Give All Information Completely  
Make Required Affidavit  
Mail or Deliver Report to:  
Conservation Division  
State Corporation Commission  
800 Bittling Building  
Wichita, Kansas

OR

Strike out upper line  
when reporting plugging  
of formations.

FORMATION PLUGGING RECORD

Barton County. Sec 12 Twp 20S Rge 12 (W)  
~~12~~

Location as "NE $\frac{1}{4}$ NW $\frac{1}{4}$ SW $\frac{1}{4}$ " or footage from lines NW/4 NW/4 NE/4

Lease Owner Sohio Petroleum Company

Lease Name Schartz "C" Well No. 1

Office Address Russell, Kansas

Character of Well (completed as Oil, Gas or Dry Hole) Dry Hole

Date well completed December 23 1947

Application for plugging filed December 29 1947

Application for plugging approved December 29 1947


Plugging commenced April 15 1948

Plugging completed April 18 1948

Reason for abandonment of well or producing formation Dry Hole

If a producing well is abandoned, date of last production Dry Hole 19    

Was permission obtained from the Conservation Division or its agents before plugging was commenced? Yes

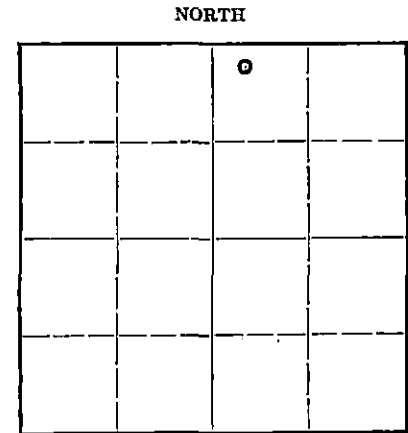

Locate well correctly on above  
Section Plat

Name of Conservation Agent who supervised plugging of this well Mr. C. D. Stough

Producing formation None Depth to top      Bottom      Total Depth of Well 3395 Feet

Show depth and thickness of all water, oil and gas formations.

OIL, GAS OR WATER RECORDS

CASING RECORD

Formation	Content	From	To	Size	Put In	Pulled Out
No commercial oil nor gas shows from top to bottom				8 5/8"	328'	None
				5 1/2"	3344'	2400'

Describe in detail the manner in which the well was plugged, indicating where the mud fluid was placed and the method or methods used in introducing it into the hold. If cement or other plugs were used, state the character of same and depth placed, from      feet to      feet for each plug set.

- 3395' to 3360' - Cement - 8 Sacks
- 3360' to 200' - Heavy Mud
- 200' to 155' - Cement - 15 Sacks
- 155' to 30' - Heavy Mud
- 30' to 6' - Cement - 8 Sacks
- 6' to 0 - Clay

(If additional description is necessary, use BACK of this sheet)

Correspondence regarding this well should be addressed to Sohio Petroleum Company  
Address Russell, Kansas

STATE OF Kansas, COUNTY OF Russell, ss.

Doyle Fair (employee of owner) ~~operator~~ of the above-described well,

being first duly sworn on oath, says: That I have knowledge of the facts, statements, and matters herein contained and the log of the above-described well as filed and that the same are true and correct. So help me God.

(Signature) Doyle Fair


4-28-48 Box 68 - Russell, Kansas  
(Address)

SUBSCRIBED AND SWORN to before me this 26th day of APR 28 1948 April 1948

My commission expires May 8, 1948.

My commission expires     

Bernie J. Smith  
Notary Public.

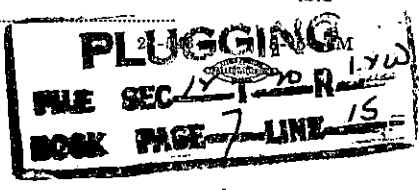

**CONTRACTOR'S VERIFIED LOG**

Operator Sohio Petroleum Company Farm Name Schartz "C" Well No. 1

Location NW NW NE Section 12-20S-12W

Pool Name Silica County Barton State Kansas

Commencement Date 11-20-47 Completion Date 12-5-47

LOG OF WELL

Depth		Formation	Deviation from Vertical (Degrees)	Remarks
From	To			
0	5	Rig		
5	15	Shale		
15	95	Sand		Ran 328' of 8 5/8" casing. Cemented with 235 sacks cement.
95	115	Shale		
115	135	Sand		
135	560	Red Bed and Shale	Syfo at 500'	
560	585	Anhydrite		
585	900	Shale		
900	1000	Salt and Shale	Syfo at 1000'	
1000	1275	Shale and Shells		
1275	1740	Broken Lime	Syfo at 1500'	
1740	1765	Sand		
1765	2165	Broken Lime	Syfo at 2000'	
2165	2695	Shale and Shells	Syfo at 2500'	
2695	3020	Lime		
3020	3080	Shale		
3080	3322	Lime - Lansing		
3322	3342	Simpson Shale		
3342	3354	Arbuckle Lime		
				Took Drill Stem Test 3101-3110'. Recovered 15' mud.
				Took Drill Stem Test 3344'-3354'. Recovered 30' oil and gas cut mud.
				Set 5 1/2" casing at 3344'. Cemented with 150 sacks cement.

PLUGGING  
 NOV 17 1947  
 NOV 15 1947

JAN 2 1948

