


Give All Information Completely
Make Required Affidavit
Mail or Deliver Report to:
Conservation Division
State Corporation Commission
212 No. Market
Wichita, Kansas

WELL PLUGGING RECORD

15.009.14492.0000
Form CP-4

NORTH

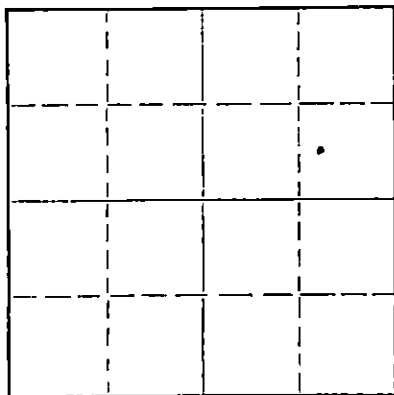

Locate well correctly on above
Section Flat

Barton County, Sec. 12 Twp. 20 Rge. (E) 12 (W)

Location as "NE/CNW&SW&" or footage from lines CWL SE NE
Lease Owner Francis Oil & Gas, Inc.
Lease Name Peter Schartz "C" Well No. 4
Office Address Ellinwood, Kansas
Character of Well (completed as Oil, Gas or Dry Hole) oil
Date well completed _____ 19____
Application for plugging filed _____ 19____
Application for plugging approved _____ 19____
Plugging commenced July 29 1967
Plugging completed August 7 1967
Reason for abandonment of well or producing formation depleted

If a producing well is abandoned, date of last production _____ 19____
Was permission obtained from the Conservation Division or its agents before plugging was commenced? yes

Name of Conservation Agent who supervised plugging of this well Donald Truan
Producing formation _____ Depth to top _____ Bottom _____ Total Depth of Well 3356 Feet
Show depth and thickness of all water, oil and gas formations.

OIL, GAS OR WATER RECORDS

CASING RECORD

FORMATION	CONTENT	FROM	TO	SIZE	PUT IN	PULLED OUT
		0	330'	8 5/8"	330'	none
		0	3328'	5 1/8"	3328'	1626.45

Describe in detail the manner in which the well was plugged, indicating where the mud fluid was placed and the method or methods used in introducing it into the hole. If cement or other plugs were used, state the character of same and depth placed, from _____ feet to _____ feet for each plug set.

Pushed plug to 3300', set 10' rock bridge and dumped 5 sacks of cement on bridge.
Pumped 20 sacks of gel and displaced with 85 sacks of cement into surface 8 5/8" at 250# pressure.

RECEIVED
STATE CORPORATION COMMISSION

8-18-67 AUG 18 1967

CONSERVATION DIVISION
WICHITA, KANSAS

(If additional description is necessary, use BACK of this sheet)

Name of Plugging Contractor Pipe Pullers, Inc.
Address Box 486, Ellinwood, Kansas

STATE OF Kansas, COUNTY OF Barton, ss.
Dean Wells (employee of owner) or (owner or operator) of the above-described well, being first duly sworn on oath, says: That I have knowledge of the facts, statements, and matters herein contained and the log of the above-described well as filed and that the same are true and correct. So help me God.

(Signature) Dean Wells
Ellinwood, Kansas

SUBSCRIBED AND SWORN to before me this 15th day of August, 1967

My commission expires July 7, 1968

Notary Public.

C E ASH et al

Peter Schartz C 4

CWL-SE-NE Sec 12-20-12W
Barton County, Kansas

Comm. Rig Up : 6-8-46
 Comm. Drilg. : 6-9-46
 Completed RD : 6-22-46
 Completed : 12-19-46
 Total Depth : 3356'

Elevation :
 Initial Prod.: 75 bbl.
 Contractor : C E Ash
 Tools : Rotary

CASING RECORD

Run	Pulled	Left In
330' - 3-5/8" Surface		330' - 3-5/8" Surface
3328' - 5 1/2" Casing		3328' - 5 1/2" Casing
33' - 4 1/2" OD 11# Liner		33' - 4 1/2" OD 11# Liner

STRATA	DEPTH
Sand	80
Shale & shells	190
Sand, shale & shells	240
Shale & shells	285
Red bed & shells	550
Anhydrate lime	580
Red bed & shells	850
Shale & shells	1040
Salt	1290
Shall & shells	1385
Lime & shale	1445
Lime	1530
Shale & shells	1705
Lime	1785
Lime & shale	2045
Lime	2135
Lime & shale	2590
Lime	2975
Shale & lime	3080
Lime	3323
Total Depth	3356

GEOLOGICAL TOPS
(Rotary Bushings)

Brown lime 3067
 KC or White lime 3086
 Arbuckle 3323

RECEIVED
 STATE CORPORATION COMMISSION

JUN 15 1967

CONSERVATION DIVISION
 Wichita, Kansas

I hereby certify that the above is the true and correct log of said well as reflected by the daily drilling reports.

Subscribed in my presence and sworn to before me this 24th day of December, 1946.

Notary Public in and for
 Sedgwick County, Kansas

My commission expires September 10, 1947