


Give All Information Completely
Make Required Affidavit
Mail or Deliver Report to:
Conservation Division
State Corporation Commission
800 Belling Building
Wichita, Kansas

OR

FORMATION PLUGGING RECORD

Strike out upper line
when reporting plug-
ging off formations.

NORTH

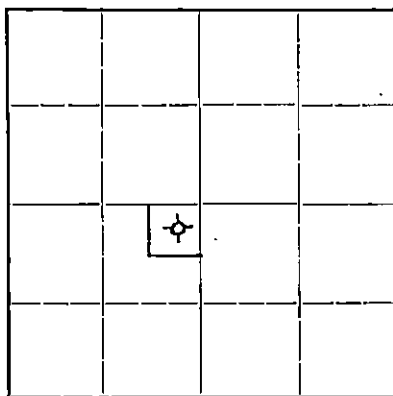

Locate well correctly on above
Section Plat

Barton County. Sec. 12 Twp. 20 Rge. 12 (X) (W)
Location as "NE $\frac{1}{4}$ NW $\frac{1}{4}$ SW $\frac{1}{4}$ " or footage from lines
Lease Owner. Comet Drilling Co.
Lease Name. M. Schartz "E" Well No. 1
Office Address. 309 Petroleum Bldg., Wichita, Kansas
Character of Well (completed as Oil, Gas or Dry Hole) Dry Hole
Date well completed. October 27, 1942
Application for plugging filed. November 10, 1942
Application for plugging approved. November 10, 1942
Plugging commenced. November 10, 1942
Plugging completed. November 12, 1942
Reason for abandonment of well or producing formation Dry

If a producing well is abandoned, date of last production. 19
Was permission obtained from the Conservation Division or its agents before plugging was com-
menced? Yes

Name of Conservation Agent who supervised plugging of this well. C. T. Alexander
Producing formation. Sil. Lime Depth to top. 3344 Bottom. 3412 Total Depth of Well. 3412 Feet
Show depth and thickness of all water, oil and gas formations.


OIL, GAS OR WATER RECORDS

CASING RECORD


Formation	Content	From	To	Size	Put In	Pulled Out
Sil. Lime	Water	3344	3412	10-3/4"	310	None
				7"	3346	1268' 9"

Describe in detail the manner in which the well was plugged, indicating where the mud fluid was placed and the method or methods used in introducing it into the hole. If cement or other plugs were used, state the character of same and depth placed, from feet to feet for each plug set.

The hole was filled with rotary mud put in by pump up to 320 feet. A wood plug and rock bridge was set at 320 to 305 with 10 sacks of cement on bridge; continued filling with rotary mud put in by pump to 15 feet; set rock bridge at 15 feet with 5 sacks cement cap put on bridge, and filled to surface with dirt

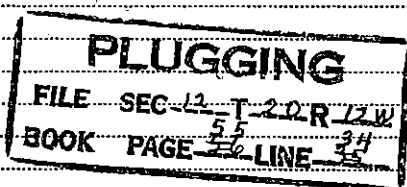

11-19-42

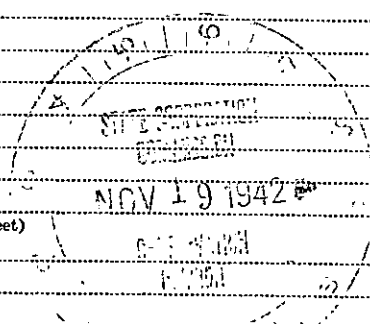

(If additional description is necessary, use BACK of this sheet)

Correspondence regarding this well should be addressed to C. E. Ash
Address. 309 Petroleum Bldg., Wichita, Kansas

STATE OF KANSAS, COUNTY OF SEDGWICK, ss.
C. E. Ash (owner or operator) of the above-described well,
being first duly sworn on oath, says: That I have knowledge of the facts, statements, and matters herein contained and the log of the above-described well as filed and that the same are true and correct. So help me God.

(Signature) C. E. Ash

309 Petroleum Bldg., Wichita, Kansas
(Address)

SUBSCRIBED AND SWORN to before me this 19th day of November, 1942.

My commission expires April 15, 1946.

Notary Public.



COMET DRILLING CO. ET AL
 M. Schartz "EP" No. 1
 C NE NE SW Sec. 12-20-12
 Barton County, Kansas


15.009.05852.0000

Comm. Rig Up :	9-29-42	Elevation :	
Comm. Drig. :	10-1-42	Initial Prod. :	Dry
Completed :	11-12-42	Contractor :	Comet Drig. Co.
Total Depth :	3412'	Tools :	Rotary

CASING RECORD

Run	Pulled	Left In
310' of 10-3/4" Surface		310' of 10-3/4"
3346' of 7" Cemented	1268' 9"	2100' 6" of 7"

STRATA	DEPTH
Sand	25
Sand & Shells	70
Shale & Shells	180
Sand	200
Shale & Shells	310
Red Bed	540
Anhydrite Line	565
Shale & Shells	1045
Salt	1300
Shale & Shells	1370
Shale & Lime	1508
Lime	1705
Sand	1715
Shale & Shells	1745
Lime	1790
Sandy Shale	1825
Lime	1993
Shale & Red Rock	2020
Shale	2028
Lime	2090
Shale	2103
Lime	2150
Shale	2170
Lime	2203
Shale & Shells	2270
Lime	2280
Shale & Lime	2385
Shale	2400
Lime	2420
Shale & Shells	2470
Lime	2555
Shale & Lime	2590
Lime	2665
Sandy Shale	2694
Lime	2992
Shale	3005
Lime	3034
Shale	3055
Lime	3070
Shale	3090
K. C. Lime	3344
Sil. Lime	3412
Sulphur Water at	3412
Total Depth	3412

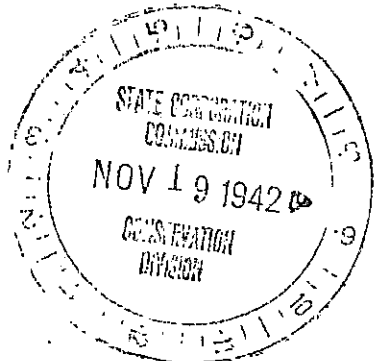

I hereby certify that the above is the true and correct log of said well as reflected by the daily drilling reports.

Beash
 Manager, Comet Drig. Co.

Subscribed in my presence and sworn to before me this 19th day of November, 1942.

Julia House
 Notary Public in and for
 Sedgwick County, Kansas.

My commission expires April 15, 1946.

PLUGGING

FILE SEC 12-T-20-R-12
 BOOK PAGE 52-LINE 24