

Give All Information Completely
Make Required Affidavit
Mail or Deliver Report to:
Conservation Division
State Corporation Commission
211 No. Broadway
Wichita, Kansas

WELL PLUGGING RECORD

Barton County. Sec. 24 Twp. 20 Rge. (E) 11W(W)

Location as "NE/CNW/SW" or footage from lines CSL N/2 NW

Lease Owner Lario Oil & Gas Company

Lease Name Peter Well No. 4

Office Address 301 S. Market, Wichita, Kansas 67202

Character of Well (completed as Oil, Gas or Dry Hole) Oil

Date well completed January 26 19 37

Application for plugging filed August 3 19 66

Application for plugging approved August 4 19 66


Plugging commenced August 12 19 66

Plugging completed August 21 19 66

Reason for abandonment of well or producing formation Depleted

If a producing well is abandoned, date of last production February 27 19 66

Was permission obtained from the Conservation Division or its agents before plugging was commenced? Yes

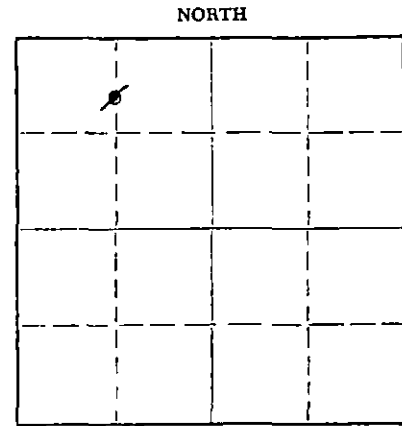

Locate well correctly on above Section Plat

Name of Conservation Agent who supervised plugging of this well Leo Massey

Producing formation Arbuckle Depth to top 3255 Bottom _____ Total Depth of Well 3261 Feet

Show depth and thickness of all water, oil and gas formations.

OIL, GAS OR WATER RECORDS

CASING RECORD

| FORMATION | CONTENT | FROM | TO | SIZE | PUT IN | PULLED OUT |
|-----------|---------|------|----|---------|--------|------------|
| | | | | 12 1/2" | 150 | None |
| | | | | 8 5/8" | 3255 | 1398 |
| | | | | | | |
| | | | | | | |
| | | | | | | |
| | | | | | | |
| | | | | | | |
| | | | | | | |

Describe in detail the manner in which the well was plugged, indicating where the mud fluid was placed and the method or methods used in introducing it into the hole. If cement or other plugs were used, state the character of same and depth placed, from _____ feet to _____ feet for each plug set.

Filled with sand from 3261' to 3230'. Run 6 sacks of cement from 3230' to 3210'. Mud from 3210' to 160'. Rock bridge from 160' to 150'. Run 35 sacks of cement from 150' to 105'. Mud from 105' to 20'. Rock bridge and 15 sacks of cement to base of cellar.

RECEIVED
STATE CORPORATION COMMISSION
8-31-66
AUG 31 1966
CONSERVATION DIVISION
Wichita, Kansas

(If additional description is necessary, use BACK of this sheet)
Name of Plugging Contractor Glenn & Smith Pipe Pulling Co. (Permit No. 396)
Address Box 156, Ellinwood, Kansas

STATE OF Kansas COUNTY OF Sedgwick, ss.
G. R. Kelsey (employee of owner) or (owner or operator) of the above-described

well, being first duly sworn on oath, says: That I have knowledge of the facts, statements, and matters herein contained and the log of the above-described well as filed and that the same are true and correct. So help me God.

(Signature) G. R. Kelsey
301 S. Market, Wichita, Kansas 67202
(Address)

SUBSCRIBED AND SWORN to before me this 30th day of August, 19 66

My commission expires July 21, 1970 Frances Leslie Notary Public.

15.009.14693.0000

WELL LOG BUREAU - KANSAS GEOLOGICAL SOCIETY.
412 Union National Bk Bldg., Wichita, Kansas.

LARIO O & G & ATLANTIC REFG.CO.
Peter No. 4.


SEC. 24 T. 20 R. 11W
Cen SL N $\frac{1}{2}$ NW $\frac{1}{4}$

Total Depth. 3261'
Comm. 12-30-36 Comp. 1-26-37
Shot or Treated.
Contractor. Broadwater Drlg.Co.
Issued. 2-13-37

County - Barton

CASING:

12 $\frac{1}{2}$ " 150'
8 $\frac{1}{4}$ " 3255'

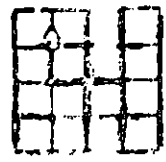

Elevation. 1765'

Production. Pot. 3019 B.

Figures Indicate Bottom of Formations.

| | |
|---------------------|------|
| sand | 65 |
| shale red | 180 |
| shale red & shale | 412 |
| lime & anhydrite | 430 |
| shale & sholls | 920 |
| salt & shale | 1240 |
| shale & sholls | 1344 |
| lime | 1362 |
| lime sholls & shale | 1455 |
| shale | 1488 |
| lime & shale | 1500 |
| brkn lime | 1642 |
| shale | 1654 |
| lime | 1676 |
| lime & shale | 1707 |
| lime sholls & shale | 1815 |
| lime & shale | 1920 |
| lime sholls & shale | 2025 |
| lime | 2045 |
| lime sholls & shale | 2094 |
| shale & shells | 2272 |
| lime sholls & shale | 2354 |
| lime | 2441 |
| shale | 2487 |
| lime | 2493 |
| lime & shale | 2516 |
| lime | 2625 |
| shale | 2654 |
| lime | 2758 |
| shale | 2778 |
| lime | 2790 |
| shale | 2801 |
| lime & shale | 2905 |
| shale | 2935 |
| shale & sholls | 2989 |
| shale | 3026 |
| 3026-3018 SIM | |
| lime & shale | 3054 |
| lime | 3138 |
| shale | 3207 |
| lime | 3254 |
| shale | 3255 |
| dolomite | 3261 |

cored 3254-57
Total Depth.

Top Kansas City 3008
Top Arbuckle 3255
Filled up and flowed thru 8" csg in 35 min.

RECEIVED
STATE CORPORATION COMMISSION

AUG 4 1966

CONSERVATION DIVISION
Wichita, Kansas