

CARD MUST BE TYPED

STATE OF KANSAS
NOTICE OF INTENTION TO DRILL
(see rules on reverse side)

CARD MUST BE SIGNED

Starting Date: January 10, 1985
month day year

API Number 15- ²⁰⁹⁶ 145- ³⁷⁰ 21, 780-0000

OPERATOR: License # 4134
Name Douglas P. Meyer Oil Investments
Address 135 West 4th
City/State/Zip Russell Kansas 67665
Contact Person Douglas P. Meyer
Phone (913) 483-4501

C. N/2. N/2 ^{SW} Sec 9... Twp 23.. S, Rge 17W. East West
(location)
2310 Ft North from Southeast Corner of Section
3960 Ft West from Southeast Corner of Section
(Note: Locate well on Section Plat on reverse side)

CONTRACTOR: License # ⁵⁶⁷¹
Name Revlin Drilling Company
City/State Russell Kansas 67665

Nearest lease or unit boundary line 330 feet.
County Pawnee
Lease Name Brooks Estate Well# 1

Well Drilled For: Well Class: Type Equipment:
 Oil Swd Infield Mud Rotary
 Gas Inj Pool Ext. Air Rotary
 OWWO Expl Wildcat Cable

Domestic well within 330 feet: yes no
Municipal well within one mile: yes no

If OWWO: old well info as follows:
Operator
Well Name
Comp Date Old Total Depth
Projected Total Depth 4400 feet
Projected Formation at TD Mississippi
Expected Producing Formations Conglomerate Chert...

Depth to Bottom of fresh water ¹⁰⁰ feet
Lowest usable water formation ^{Parkota}
Depth to Bottom of usable water ³⁰⁰ feet
Surface pipe by Alternate: 1 2
Surface pipe to be set ²⁵⁰⁻ ³⁰⁰ feet
Conductor pipe if any required None feet
Ground surface elevation ⁷¹⁵ feet MSL
This Authorization Expires ⁷⁻³⁻⁸⁵
Approved By ¹⁻³⁻⁸⁵ *[Signature]*

I certify that we will comply with K.S.A. 55-101, et seq., plus eventually plugging hole to K.C.C. specifications.

Date December 19, 1984
Signature of Operator or Agent *[Signature]*


Title Owner
[Signature]

mhc/wake 1/3/85

Must be filed with the K.C.C. five (5) days prior to commencing well
This card void if drilling not started within six (6) months of date received by K.C.C.

Important procedures to follow :

**A Regular Section of Land
1 Mile = 5,280 Ft.**

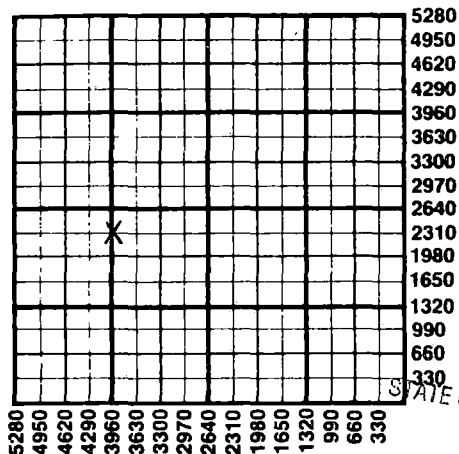

1. Notify District office before setting surface casing.
2. Set surface casing by circulating cement to the top.
3. File completion forms ACO-1 with K.C.C. within 90 days of well completion, following instructions on ACO-1, side 1, and including copies of wireline logs.
4. Notify District office 48 hours prior to old well workover or re-entry.
5. Prior to plugging, prepare a plugging plan, then obtain agreement from the appropriate district office for an approved plugging plan.
6. Submit plugging report (CP-4) to K.C.C. after plugging is completed.
7. Obtain an approved injection docket number before disposing of salt water.
8. Notify K.C.C. within 10 days when injection commences or terminates.
9. If an alternate 2 completion, cement in the production pipe from below any usable water to surface within 120 days of spud date.

RECEIVED
STATE CORPORATION COMMISSION

JAN 03 1985

CONSERVATION DIVISION
Wichita, Kansas

State Corporation Commission of Kansas
Conservation Division
200 Colorado Derby Building
Wichita, Kansas 67202
(316) 263-3238