


STATE OF KANSAS
STATE CORPORATION COMMISSION

Give All Information Completely
Make Required Affidavit
Mail or Deliver Report to:
Conservation Division
State Corporation Commission
212 No. Market
Wichita, Kansas

WELL PLUGGING RECORD

NORTH

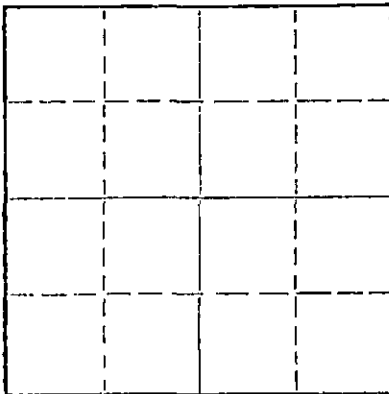

Locate well correctly on above
Section Plot

Barton County. Sec. 10 Twp. 20S Rge. (E) 11(W)
Location as "NE/CNW&SW¼" or footage from lines C S/2 N/2 NW
Lease Owner Clinton Oil Company
Lease Name Ringering Well No. 3-D
Office Address 6810 W. Hi-way 54, Wichita, Kansas 67209
Character of Well (completed as Oil, Gas or Dry Hole) Dry Hole
Date well completed Verbal Approval 19
Application for plugging filed Verbal Approval 19
Application for plugging approved November 29 19 68
Plugging commenced November 29 19 68
Plugging completed 19
Reason for abandonment of well or producing formation _____

If a producing well is abandoned, date of last production _____ 19____
Was permission obtained from the Conservation Division or its agents before plugging was commenced? Yes

Name of Conservation Agent who supervised plugging of this well Donald Truan
Producing formation _____ Depth to top _____ Bottom _____ Total Depth of Well _____ Feet
Show depth and thickness of all water, oil and gas formations.

OIL, GAS OR WATER RECORDS

CASING RECORD

FORMATION	CONTENT	FROM	TO	SIZE	PUT IN	PULLED OUT
				8-5/8"	181	None

Describe in detail the manner in which the well was plugged, indicating where the mud fluid was placed and the method or methods used in introducing it into the hole. If cement or other plugs were used, state the character of same and depth placed, from _____ feet to _____ feet for each plug set.

Filled hole with heavy rotary mud from 3,344 feet (Rotary Total Depth) to 400 feet. Set bottom plug at 400 feet and cemented with 45 sacks cement. Filled hole with heavy rotary mud to 180 feet. Set plug at 180 feet and cemented with 25 sacks cement. Filled hole with heavy rotary mud to 40 feet. Set plug at 40 feet and cemented to cellar with 10 sacks cement, 2 sacks cement in rathole.

RECEIVED
STATE CORPORATION COMMISSION
DEC 9 1968
CONSERVATION DIVISION
Wichita, Kansas

12-9-68

(If additional description is necessary, use BACK of this sheet)

Name of Plugging Contractor H-30, INC.
Address 200 N. Main St., Wichita, Kansas 67202

STATE OF KANSAS, COUNTY OF SEDGWICK, ss.

Arlo B. Romer (employee of owner) or (owner or operator) of the above-described well, being first duly sworn on oath, says: That I have knowledge of the facts, statements, and matters herein contained and the log of the above-described well as filed and that the same are true and correct. So help me God.

(Signature) Arlo B. Romer
200 N. Main, Wichita, Kansas 67202
(Address)

SUBSCRIBED AND SWORN TO before me this 6th day of December, 1968

My commission expires April 21, 1971

Martha Hartpence
Martha Hartpence
Notary Public.

KANSAS GEOLOGICAL SOCIETY
 KANSAS WELL LOG BUREAU - KANSAS WELL SAMPLE BUREAU
 KANSAS GEOLOGICAL SOCIETY BUILDING
 508 EAST MURDOCK - WICHITA, KANSAS

15-009.20295.0000

COMPANY Clinton Oil Company

SEC. 10 T. 20S R. 11W
 LOC. C S/2 N/2 NW

FARM Ringering NO. 3-D

COUNTY Barton


TOTAL DEPTH 3,344

COMM. November 20, 1968 COMP. November 29, 1968

SHOT OR TREATED

CONTRACTOR H-30, INC.

ISSUED

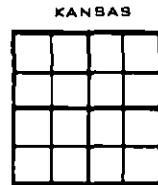

CASING

20	10		
15	8 - 5/8"	181' cemented w/150 sx cement	ELEVATION 1766 KB
12	6		
13	5		

PRODUCTION

FIGURES INDICATE BOTTOM OF FORMATIONS

SAMPLE TOPS

Sand & Gravel	40	Anhydrite	496	+ 1270
Sand	55	Base Anhydrite	512	+ 1254
Hard Sand & Sand Rock	70	Howard	2543	- 777
Sand & Shale	182	Topeka	2637	- 871
Red Bed	496	Queen Hill	2808	- 1042
Anhydrite	512	Heebner	2903	- 1137
Shale	935	Toronto	2921	- 1155
Shale, Shells & Salt	1450	Douglas	2936	- 1170
Lime	1970	Brown Lime	3028	- 1262
Lime & Shale	2337	Lansing	3049	- 1283
Shale w/Lime Streaks	2610	Base K.C.	3305	- 1539
Shale & Lime	2720	Arbuckle	3309	- 1543
Lime & Shale	2825	Rotary T.D.	3344	- 1578
Lime	2903			
Shale	2906			
Lime & Shale	2915			
Lime	2995			
Lime & Shale	3080			
Lime	3344			
Rotary Total Depth	3344			

RECEIVED
 STATE CORPORATION COMMISSION
 DEC 9 1968
 CONSERVATION DIVISION
 Wichita, Kansas

I hereby certify the above and foregoing to be a true and correct log of the above described well as shown by the drilling reports.

H-30, INC.

Arlo B. Romer
 Arlo Romer

STATE OF KANSAS }
 COUNTY OF SEDGWICK } SS:

Subscribed and Sworn to before me a Notary Public in and for said county and state this 6th day of December, 1968.

Martha Hartpence
 Martha Hartpence Notary Public

My Commission Expires:

April 21, 1971