

STATE OF KANSAS  
STATE CORPORATION COMMISSION

WELL PLUGGING RECORD

Give All Information Completely  
Make Required Affidavit  
Mail or Deliver Report to:  
Conservation Division  
State Corporation Commission  
211 No. Broadway  
Wichita, Kansas

Barton County, Sec. 11 Twp. 16 S Rge. (E) 13 (W)

Location as "NE/CNW%SW%" or footage from lines SW/4 SE/4 NE/4

Lease Owner Messman-Rinehart Oil Company

Lease Name Ehrlich Well No. 1

Office Address 1432 Wichita Plaza Bldg., Wichita, Kansas

Character of Well (completed as Oil, Gas or Dry Hole) Dry Hole

Date well completed June 3 19 64

Application for plugging filed June 4 19 64

Application for plugging approved June 4 19 64


Plugging commenced June 4 19 64

Plugging completed June 4 19 64

Reason for abandonment of well or producing formation Dry

If a producing well is abandoned, date of last production 19

Was permission obtained from the Conservation Division or its agents before plugging was commenced?

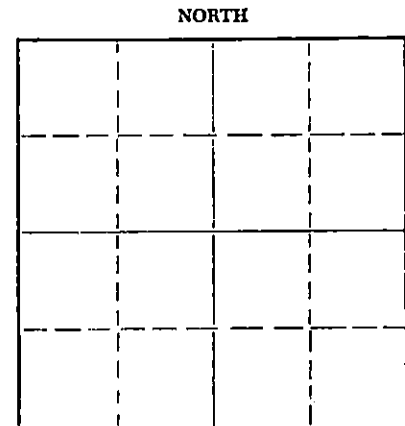

Locate well correctly on above Section Plat

Name of Conservation Agent who supervised plugging of this well Mr. Donald Truan, 634 Sunset, Russell, Kansas

Producing formation Depth to top Bottom Total Depth of Well 3410' Feet

Show depth and thickness of all water, oil and gas formations.

OIL, GAS OR WATER RECORDS

CASING RECORD

FORMATION	CONTENT	FROM	TO	SIZE	PUT IN	PULLED OUT
				8-5/8"	291'	none

Describe in detail the manner in which the well was plugged, indicating where the mud fluid was placed and the method or methods used in introducing it into the hole. If cement or other plugs were used, state the character of same and depth placed, from feet to feet for each plug set.

Set plug at 280 ft. with 25 sx. cement and 1/2 sk. hulls. Hulls and cement to bottom of cellar

RECEIVED  
STATE CORPORATION COMMISSION

JUN 11 1964 6-11-64

CONSERVATION DIVISION  
Wichita, Kansas

(If additional description is necessary, use BACK of this sheet)

Name of Plugging Contractor Messman-Rinehart Oil Company

Address 1432 Wichita Plaza Bldg., Wichita, Kansas

STATE OF Kansas, COUNTY OF Sedgwick, ss. J. A. Gilliland

(employee of owner) of the above-described well, being first duly sworn on oath, says: That I have knowledge of the facts, statements, and matters herein contained and the log of the above-described well as filed and that the same are true and correct. So help me God.

(Signature) J. A. Gilliland

1432 Wichita Plaza Bldg., Wichita, Kansas (Address)

SUBSCRIBED AND SWORN TO before me this 10th day of June, 1964

My commission expires December 1, 1964

Barbara J. Scott, Notary Public.

15W9-01546-0000

NO. 1 EHRLICH

Well Record:

Location: SW/4 SE/4 NE/4, Sec. 11-16S-13W  
Barton County, Kansas

Commenced: May 25, 1964

Operator: Messman-Rinehart Oil Company  
1432 Wichita Plaza Bldg.  
Wichita, Kansas

Completed: June 3, 1964

Elevation 1913' K/S

Production: D & A

Contractor: Messman-Rinehart Oil Company  
1432 Wichita Plaza Bldg.  
Wichita, Kansas

Casing Record: 8-5/8" @ 291' w/155 sx. cam.

**\*\*\* LOG \*\*\***

(Figures indicate bottom of formation)

Surface Clay and Post Rock	80
Shale w/Lime Streaks	291
Shale	435
Sand Streaks	560
Shale and Red Bed	875
Anhydrite	915
Shale & Shells	1605
Lime & Shale	2100
Shale & Lime	2350
Lime & Shale	2670
Shale & Lime	2790
Lime & Shale	2875
Lime	2985
Lime & Shale	3005
Lime	3080
Shale & Sand	3130
Lime	3365
Lime & ?	3405
Lime	3410 R.T.D.

Sample Tops:

2773'	- Topeka (-860')
2957'	- Queen Hill (-1044')
3043'	- Heebner (-1130)
3129'	- Brown Lime (-1216)
3141'	- Lansing (-1228')
3389'	- Cherty Conglomerate (-1476')
3393'	- Arbuckle (-1480')

The undersigned, MESSMAN-RINEHART OIL COMPANY, hereby certifies that the above log is a true and correct log of the formation encountered in drilling the above well as reflected by the Daily Drilling Reports.

MESSMAN-RINEHART OIL COMPANY

By: \_\_\_\_\_

*J. A. Gilliland*  
J. A. Gilliland

Subscribed and sworn to before me  
this 10th day of June, 1964

*Barbara J. Scott*  
Barbara J. Scott, Notary Public

My Commission Expires: December 1, 1964

RECEIVED  
STATE CORPORATION COMMISSION

JUN 11 1964

CONSERVATION DIVISION  
Wichita, Kansas