


15-009-01150-0000

STATE OF KANSAS
STATE CORPORATION COMMISSION

Give All Information Completely
Make Required Affidavit
Mail or Deliver Report to:
Conservation Division
State Corporation Commission
211 No. Broadway
Wichita, Kansas

WELL PLUGGING RECORD

NORTH

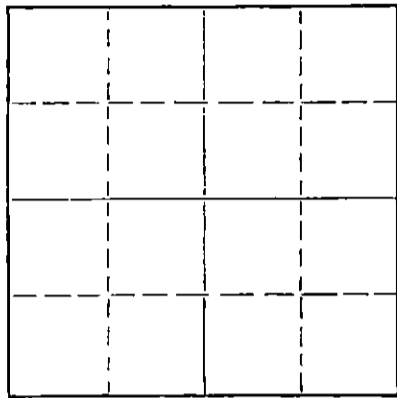

Locate well correctly on above
Section Plat

Barton County. Sec. 13 Twp. 16S Rge. 13 (E) W (W)
Location as "NE/CNW/SW" or footage from lines NW NW NW
Lease Owner Shelley-Miller Drilling Company
Lease Name Hofmeister Well No. 1
Office Address 205 Miller Building, Wichita, Kansas
Character of Well (completed as Oil, Gas or Dry Hole) Dry Hole
Date well completed May 10 19 58
Application for plugging filed May 10 19 58
Application for plugging approved May 10 19 58
Plugging commenced May 10 19 58
Plugging completed May 10 19 58
Reason for abandonment of well or producing formation Failure to produce
in commercial quantities
If a producing well is abandoned, date of last production 19
Was permission obtained from the Conservation Division or its agents before plugging was com-
menced? Yes

Name of Conservation Agent who supervised plugging of this well Don Truman
Producing formation _____ Depth to top _____ Bottom _____ Total Depth of Well 3440 Feet
Show depth and thickness of all water, oil and gas formations.

OIL, GAS OR WATER RECORDS

CASING RECORD

FORMATION	CONTENT	FROM	TO	SIZE	PUT IN	PULLED OUT
				8 5/8	305'	

Describe in detail the manner in which the well was plugged, indicating where the mud fluid was placed and the method or methods used in introducing it into the hole. If cement or other plugs were used, state the character of same and depth placed, from _____ feet to _____ feet for each plug set.

Bottom plug set @ 300' with 25 sacks cement 1/3 sack hulls
Top plug set @ 40' with 10 sacks cement 1/3 sack hulls

(If additional description is necessary, use BACK of this sheet)

Name of Plugging Contractor _____
Address _____

STATE OF KANSAS, COUNTY OF SEDGWICK, ss.
Richard A. Shelley (employee of owner) or (owner or operator) of the above-described well, being first duly sworn on oath, says: That I have knowledge of the facts, statements, and matters herein contained and the log of the above-described well as filed and that the same are true and correct. So help me God.

(Signature) Richard A. Shelley
205 Miller Building, Wichita, Kansas
(Address)

SUBSCRIBED AND SWORN to before me this 19th day of May, 19 58

My commission expires March 24, 1960

Leon M. Somers
Notary Public.

5-20-58 MAY 20 1958

PLUGGING
FILE SEC. 13 T. 16 R. 13W
BOOK PAGE 100 LINE 33

COMPANY: Shelley-Miller Drilling Company
205 Miller Building
Wichita, Kansas

Rotary Drilling Commenced: 5-1-58
Rotary Drilling Completed: 5-10-58

LOCATION: Hofmeister No. 1
NW NW Sec. 13-16S-13W
Barton County, Kansas

CONTRACTOR: Shelley-Miller Drilling Company
205 Miller Building
Wichita, Kansas

CASING RECORD: 8 5/8" casing set @ 305' cemented with 175 sacks

L O G
(Measurements from top of Rotary Bushing to bottom of formation)

Clay	20
Lime Stone & Shale	100
Shale & Shells	450
Shale & Red Bed	655
Red Bed & Shale	865
Anhydrite	900
Shale & Shells	1,270
Lime & Shale	1,575
Lime	1,700
Lime & Shale	2,720
Lime	3,440 Rotary T.D.

The undersigned, Richard A. Shelley, Partner of Shelley-Miller Drilling Company, hereby certifies in behalf of said company, that the above log is a true and correct log of the formation encountered in drilling the above well as reflected by the Daily Drilling Reports.

SHELLEY-MILLER DRILLING COMPANY

By *Richard A. Shelley*

STATE OF KANSAS)
COUNTY OF SEDGWICK) SS

BE IT REMEMBERED, that on this 14th day of May, 1958, before me, the undersigned, a Notary Public, duly commissioned in and for the county and state aforesaid, came Richard A. Shelley, Partner, and known to me to be the same person who executed the foregoing instrument of writing in behalf of Shelley-Miller Drilling Company, as a Partner of said company, and he duly acknowledged the execution of the same for himself and for said company.

IN WITNESS WHEREOF, I have hereunto set my hand and official seal on the day and year last above written.

Louisa M. Fowler
Notary Public

My Commission Expires:
March 24, 1960

RECEIVED
MAY 20 1958
DIVISION

PLUGGING
FILE SEC. 13 T. 16 R. 13W
BOOK PAGE 100 LINE 33