


STATE OF KANSAS
STATE CORPORATION COMMISSION

WELL PLUGGING RECORD

Give All Information Completely
Make Required Affidavit
Mail or Deliver Report to:
Conservation Division
State Corporation Commission
800 Bittling Building
Wichita, Kansas

NORTH

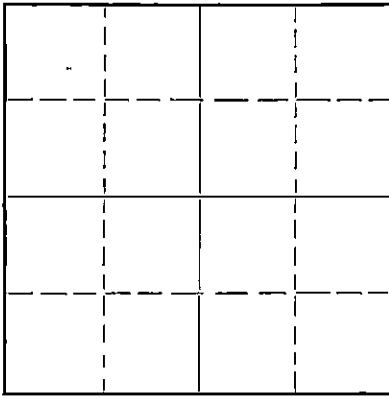

McPherson County. Sec. 2 Twp. 19 Rge. (E) 1 (W) 1
Location as "NE/CNW¼SW¼" or footage from lines NE NW SE
Lease Owner Westgate-Greenland Oil Company
Lease Name Johnson Well No. 1
Office Address 1022 Union National Bank Building, Wichita 2, Kansas
Character of Well (completed as Oil, Gas or Dry Hole) dry hole
Date well completed July 3, 1950 19
Application for plugging filed July 3, 1950(Orally) 19
Application for plugging approved July 6, 1950(written) 19
Plugging commenced July 3, 1950 19
Plugging completed July 3, 1950 19
Reason for abandonment of well or producing formation

If a producing well is abandoned, date of last production 19
Was permission obtained from the Conservation Division or its agents before plugging was commenced? yes

Name of Conservation Agent who supervised plugging of this well Ruel Durkee
Producing formation Depth to top Bottom Total Depth of Well Feet
Show depth and thickness of all water, oil and gas formations.


OIL, GAS OR WATER RECORDS

CASING RECORD

Formation	Content	From	To	Size	Put In	Pulled Out
surface		0	136	8 5/8"	136	none

Describe in detail the manner in which the well was plugged, indicating where the mud fluid was placed and the method or methods used in introducing it into the hole. If cement or other plugs were used, state the character of same and depth placed, from feet to feet for each plug set.

Filled hole with heavy mud from 2898 feet to 135 feet
Set wooden plug and dumped 15 sacks cement
Filled with heavy mud to 15 feet and set wooden plug
Dumped 5 sacks cement to cellar base.

 

JUL 8 - 1950 7-8-50

SE
CON
KANSAS

(If additional description is necessary, use BACK of this sheet)

Correspondence regarding this well should be addressed to Westgate-Greenland Oil Company
Address 1022 Union National Bank Building, Wichita 2, Kansas

STATE OF Kansas, COUNTY OF Sedgwick, ss.
G. E. Bitler (employee of owner) of the above-described well,
being first duly sworn on oath, says: That I have knowledge of the facts, statements, and matters herein contained and the log of the above-described well as filed and that the same are true and correct. So help me God.

(Signature)

G. E. Bitler


1022 Union National Bank Building, Wichita 2, Kansas
(Address)

SUBSCRIBED AND SWORN to before me this 7th day of July, 1950.

Etha Russell

Notary Public.

My commission expires May 25, 1953

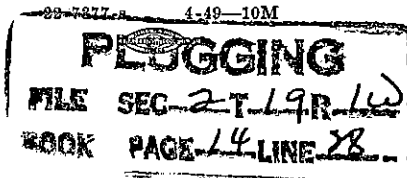

COMPANY: Westgate Greenland Oil Co.
 CONTRACTOR: Jackson Drilling Corporation
 FARM: Johnson #1
 LOCATION: NE NW SE Section 2-19-1W,
 McPherson County, Kansas
 ELEVATION: 1542
 COMMENCED: June 26, 1950
 COMPLETED: July 4, 1950

0 to 15	Clay and Sand
15 to 138	Shale
138 to 335	Shale and Shells
335 to 460	Lime
460 to 670	Lime and Shale
670 to 920	Lime
920 to 1150	Lime and Shale
1150 to 1425	Shale, Sandy
1425 to 1780	Shale and Lime
1780 to 1805	Lime
1805 to 1915	Lime and Shale
1915 to 1960	Lime
1960 to 2291	Lime and Shale
2291 to 2310	Shale
2310 to 2395	Lime and Shale
2395 to 2516	Lime
2516 to 2530	Shale
2530 to 2552	Lime
2552 to 2590	Lime and Shale
2590 to 2656	Shale
2656 to 2819	Shale and Lime
2819 to 2850	Shale
2850 to 2871	Chat
2871 to 2897	Mississippi Lime, Cherty
2897 to 2898	Lime
2898 T.D.	

8 5/8" 32# casing set at 136 feet. Cemented with 125 sacks cement and 1 sack calcium chloride.

Top: Mississippi 2852

Dry and abandoned.

All measurements from top of derrick floor.

RECEIVED
 Conservation Div.
 JUL 10 1950
 STATE CORPORATION
 COMMISSION
 KANSAS

C E R T I F I C A T E

I, Clare A. Stewart, do hereby certify that the above and foregoing is a true and correct copy of log of the Johnson #1, Section 2-19-1W, McPherson County, Kansas, as reflected by files of the Jackson Drilling Corporation.

Clare A. Stewart
 Clare A. Stewart

Subscribed and sworn to before me, a Notary Public, within and for Johnson County, Kansas, this 7th day of July, 1950.

Dorothy J. Wilson
 Dorothy J. Wilson

PLUGGING
 FILE SEC 2 T 19 R 1 W
 BOOK PAGE 14 LINE 28