


Give All Information Completely
Make Required Affidavit
Mail or Deliver Report to:
Conservation Division
State Corporation Commission
800 Biting Building
Wichita, Kansas

WELL PLUGGING RECORD

NORTH

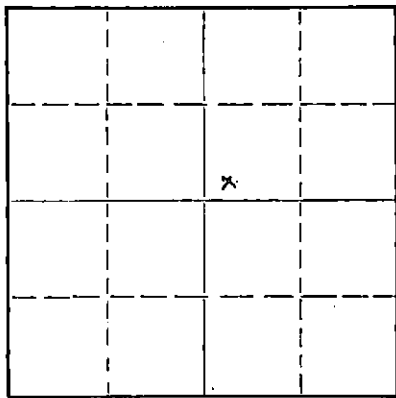

Locate well correctly on above
Section Plat

Barton County, Sec. 5 Twp. 20 Rge. 11 (W)
Location as "NE/CNW/SW" or footage from lines SW SW NE
Lease Owner The Duke Drilling Company
Lease Name O. Soeken Well No. 3
Office Address P. O. Box 123, Great Bend, Kansas
Character of Well (completed as Oil, Gas or Dry Hole) dry hole
Date well completed 11/13 1955
Application for plugging filed 11/13 1955
Application for plugging approved 11/13 1955
Plugging commenced 11/13 1955
Plugging completed 11/13 1955
Reason for abandonment of well or producing formation dry hole

If a producing well is abandoned, date of last production 19
Was permission obtained from the Conservation Division or its agents before plugging was commenced? yes

Name of Conservation Agent who supervised plugging of this well Russell Brundage
Producing formation Arbuckle Depth to top 3313 Bottom 3340 Total Depth of Well 3340 Feet
Show depth and thickness of all water, oil and gas formations.

OIL, GAS OR WATER RECORDS

CASING RECORD

FORMATION	CONTENT	FROM	TO	SIZE	PUT IN	PULLED OUT
Water sand		0	50			
		60	70			
				8-5/8	209	none

Describe in detail the manner in which the well was plugged, indicating where the mud fluid was placed and the method or methods used in introducing it into the hole. If cement or other plugs were used, state the character of same and depth placed, from feet to feet for each plug set.

Filled hole with Hy mud to 205' set 1/3 sk. hulls and plug with 20 sks. Fill hole Hy mud to 35' 1/3 sk. hulls. HOWCO plug & 10 sack cement. 2 sk. in rat hole

(If additional description is necessary, use BACK of this sheet)

Name of Plugging Contractor The Duke Drilling Company
Address P. O. Box 123, Great Bend, Kansas

STATE OF Kansas, COUNTY OF Barton, ss.
Cecil M. Olson (employee of owner) or (owner) of the above-described well, being first duly sworn on oath, says: That I have knowledge of the facts, statements, and matters herein contained and the log of the above-described well as filed and that the same are true and correct. So help me God.

(Signature) Cecil M. Olson
P. O. Box 123, Great Bend, Kansas (Address)

SUBSCRIBED AND SWORN to before me this 17th day of November, 19 55

My commission expires June 24, 1959

Clair E. Steinson Notary Public.

PLUGGING
FILE SEC 5 T 20 R 11 W
BOOK PAGE 16 LINE 27

RECEIVED
STATE CORPORATION COMMISSION
NOV 19 1955 11-19-55
CONSERVATION DIVISION
Wichita, Kansas

W E L L L O G

Elevation	1779 K.B.		Soeken #3
Anhydrite	535'	(Drillers)	SW SW NE
Heebner	2923'	(-1144')	Sec. 5-20-11
Brown lm.	3047'	(-1268')	Barton County
Lansing	3065'	(-1286')	
Conglomerate	3305'	(-1526')	Started 11/3/55
Arbuckle	3313'	(-1534')	Completed 11/14/55
R.T.D.	3340'	(-1561')	


0 - 50'	sand
50 - 60'	clay
60 - 70'	sand
70 - 95'	clay
95 - 117'	dry sand
117 - 120'	blue shale
120 - 160'	sand
160 - 215'	blue shale
215 - 535'	red bed
535 - 575'	anhydrite
575 - 1085'	shale and shell
1085 - 1170'	shale and shell
1170 - 1300'	salt and shale
1300 - 1575'	shale and shell
1575 - 1690'	lime and shale
1690 - 1815'	broken lime
1815 - 2045'	lime and shale
2045 - 2420'	lime and shale
2420 - 2628'	lime and shale
2628 - 2830'	lime
2830 - 2923'	lime
2923 - 2945'	Heebner
2945 - 3065'	lime
3065 - 3085'	lansing
3085 - 3145'	lime
3145 - 3285'	lime
3285 - 3305'	lime
3305 - 3313'	Conglomerate
3313 - 3390'	Arbuckle
3330 - 3340'	Arbuckle
3340'	R. T. D.

A F F I D A V I T

State of Kansas; county of Barton, s.s., first being duly sworn on oath state: That I have knowledge of the facts, statements and matter herein contained and that the same are true and correct.

THE DUKE DRILLING COMPANY

County of Barton, State of Kansas

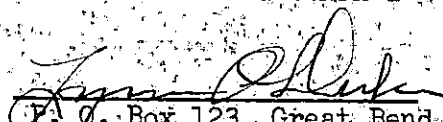this 21 day of November, 1955

 P. O. Box 123, Great Bend, Kansas


 NOTARY PUBLIC
My commission expires June 24, 1959