


WELL PLUGGING RECORD

Give All Information Completely
Make Required Affidavit
Mail or Deliver Report to:
Conservation Division
State Corporation Commission
800 Bittling Building
Wichita, Kansas

NORTH

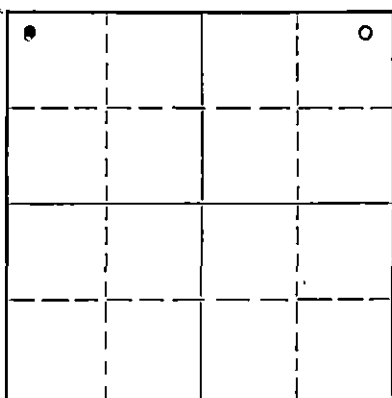

Locate well correctly on above
Section Plat

BARTON County. Sec. 4 Twp. 20 Rge. (E) 11 (W)
Location as "NE/CNW $\frac{1}{4}$ SW $\frac{1}{4}$ " or footage from lines NE $\frac{1}{4}$ NE $\frac{1}{4}$ NE $\frac{1}{4}$
Lease Owner Edw. H. Isern, et al
Lease Name Schmidt Well No. 2
Office Address Box 92, Ellinwood, Kansas
Character of Well (completed as Oil, Gas or Dry Hole) Dry Hole
Date well completed 10-14-50 19.
Application for plugging filed 10-14-50 19.
Application for plugging approved 10-14-50 19.
Plugging commenced 10-14-50 19.
Plugging completed 10-14-50 19.
Reason for abandonment of well or producing formation Dry Hole

If a producing well is abandoned, date of last production 19.
Was permission obtained from the Conservation Division or its agents before plugging was commenced? Yes

Name of Conservation Agent who supervised plugging of this well C. D. Stough
Producing formation Depth to top Bottom Total Depth of Well 3395 Feet
Show depth and thickness of all water, oil and gas formations.

OIL, GAS OR WATER RECORDS

CASING RECORD

Formation	Content	From	To	Size	Put In	Pulled Out
Surface pipe		0	210'	8 5/8"	210'	None

Describe in detail the manner in which the well was plugged, indicating where the mud fluid was placed and the method or methods used in introducing it into the hole. If cement or other plugs were used, state the character of same and depth placed, from _____ feet to _____ feet for each plug set.

Mudded hole with heavy mud to 210'. Bridged and cemented with 15 sacks cement.
Mudded to 30', bridged and cemented with 10 sacks

RECEIVED
STATE CORPORATION COMMISSION

NOV 25 1950 11-25-50

CONSERVATION DIVISION
Wichita, Kansas

(If additional description is necessary, use BACK of this sheet)

Correspondence regarding this well should be addressed to G. W. Keyes Drilling Co
Address Box 92, Ellinwood, Kansas

STATE OF KANSAS, COUNTY OF BARTON, ss.

Edw. H. Isern, Part Owner (employee of owner) or (owner or operator) of the above-described well, being first duly sworn on oath, says: That I have knowledge of the facts, statements, and matters herein contained and the log of the above-described well as filed and that the same are true and correct. So help me God.

(Signature)

Edw. H. Isern

Ellinwood, Kansas
(Address)

SUBSCRIBED AND SWORN to before me this 23rd day of October, 1950

George A. Meyer
Notary Public.

My commission expires February 10, 1951.

PLUGGING
FILE SEC 4 T 20 R 44
BOOK PAGE 35 LINE 39

15.009.19535.0000

WELL LOG

EDW. H. ISERN, ET AL, OWNERS - Schmidt #2
NE/4 NE/4 NE/4 Section 4, Township 20, Range 11
Barton County, Kansas

Figures indicate bottom of formation

Elevation: 1779 DF

Pipe Record:

8 5/8" set at 210'

Tops RBM

Topeka 2661
Heebner 2924
Brown Lime 3052
Lansing 3071
Base K.C. 3325
Conglomerate 3384

Rotary Commenced 10-7-50
Completed 10-15-50

0 to 55 Sand
90 Shale & Sand
520 Shale & Shells
548 Anhydrite
1050 Shale & Shells
1240 Salt
1515 Shale & shells
1675 Sand & Lime
1705 Lime
1725 Sand & Lime
2010 Lime & Shale
2655 Shale & Shells
3050 Lime & Shale
3328 Lime
3385 Shale
3395 Conglomerate
3395 Total Depth D & A

STATE OF KANSAS)
COUNTY OF BARTON)

ss.

I, Edw. H. Isern, Part Owner of the above-described well, being first duly sworn on oath, declare: That I have knowledge of the facts, statements and matters herein contained pertaining to the log of the above-described well, as filed, and that the same are true and correct.

Edw. H. Isern

Subscribed and Sworn to before me this 23rd day of October, 1950.

George A. Meyer

My Commission Expires February 10, 1951.

Notary Public
RECEIVED
STATE CORPORATION COMMISSION

OCT 25 1950

CONSERVATION DIVISION
Wichita, Kansas

PLUGGING
FILE SEC-4 T 20 R 11
BOOK PAGE 35 LINE 39