

STATE OF KANSAS
STATE CORPORATION COMMISSION

WELL PLUGGING RECORD

OR
FORMATION PLUGGING RECORD

Strike out upper line
when reporting plug-
ging off formations.

Give All Information Completely
Make Required Affidavit
Mail or Deliver Report to:
Conservation Division
State Corporation Commission
800 Bittling Building
Wichita, Kansas

Barton County, Sec. 4 Twp. 20 Rge. 11W/B (W)

Location as "NE $\frac{1}{4}$ NW $\frac{1}{4}$ SW $\frac{1}{4}$ " or footage from lines NE NE SE
Lease Owner Jay Bergman Oil Company,
Lease Name A. Schmidt Well No. 2
Office Address 201 Union National Bank Bldg., Wichita, Kansas
Character of Well (completed as Oil, Gas or Dry Hole) Dry Hole
Date well completed June 23, 1948
Application for plugging filed June 23, (verbal) 1948
Application for plugging approved June 25, 1948
Plugging commenced June 23, 1948
Plugging completed June 23, 1948
Reason for abandonment of well or producing formation Dry Hole

NORTH

Locate well correctly on above
Section Plat

If a producing well is abandoned, date of last production none 19

Was permission obtained from the Conservation Division or its agents before plugging was com-
menced? Yes

Name of Conservation Agent who supervised plugging of this well C. D. Stough

Producing formation Depth to top Bottom Total Depth of Well 3341 Feet

Show depth and thickness of all water, oil and gas formations.

OIL, GAS OR WATER RECORDS

CASING RECORD

Formation	Content	From	To	Size	Put In	Pulled Out
				8-5/8"	155	none

Describe in detail the manner in which the well was plugged, indicating where the mud fluid was placed and the method or methods used in introducing it into the hole. If cement or other plugs were used, state the character of same and depth placed, from feet to feet for each plug set.

Surface pipe 8-5/8 inch circulated with cement. Hole full of heavy mud from bottom up to 158 feet. Bridge and 15 sacks of cement. Mud to 25 feet. Plug and 10 sacks of cement and filled to surface.

(If additional description is necessary, use BACK of this sheet)

Correspondence regarding this well should be addressed to Jay Bergman Oil Company,
Address 201 Union National Bank Bldg.,
Wichita, Kansas

STATE OF Kansas, COUNTY OF Sedgwick, ss.

(employee of owner) or (owner or operator) of the above-described well,
being first duly sworn on oath, says: That I have knowledge of the facts, statements, and matters herein contained and the log of the above-described well as filed and that the same are true and correct. So help me God.


(Signature)

Jay Bergman
201 Union National Bank Bldg.,
Wichita, Kansas (address)

SUBSCRIBED AND SWORN to before me this 30th day of June, 1948.

J. O. Roberts
Notary Public.

My commission expires November 5, 1951

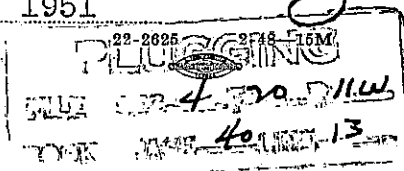

A. Schmidt No. 2 Well

Drilled for: Jay Bergman Oil Company

Sec. 4-20-11, Barton County, Kansas

Drilled by: Mouser Drilling Company

Drilling Commenced: June 11, 1948

Drilling Completed: June 23, 1948

Casing Record:

8 5/8" 155' O.D. 8 rd thd Casing

<u>FORMATION</u>	<u>DEPTH</u>	<u>FORMATION</u>	<u>DEPTH</u>
Gellar	5	Lime	2913
Sand	40	Lime and shale	2993
Sand and shale	90	Shale	3040
Blue shale	185	Lime	3218
White shale	210	Shale and lime	3237
Red bed	505	Lime	3302
Anhydrite	528	Lime and sand	3337
Shale and shells	975	Arbuckle	3341
Salt	1220		
Shale and shells	1305	Total Depth (Dry Hole)	3341
Shale and lime	1405		
Lime and shale	1590		
Shale and lime	1685		
Florence Flint	1715		
Lime and shale -	1955		
Shale	1970		
Shale and shells	2255		
Shale and lime	2405		
Lime and shale	2500		
Shale and shells	2550		
Lime and shale	2600		

STATE OF KANSAS

SS:

COUNTY OF SEDGWICK

I, the undersigned, being duly sworn on oath, state that the above and within statement is a true and correct record and log of the well drilled on the above described location to the best of my knowledge and belief.

[Signature]

Subscribed and sworn to before me this 25th day of June 1948.

My Commission Expires:

March 18, 1950

Francis L. Webber

