

STATE OF KANSAS  
STATE CORPORATION COMMISSION


Give All Information Completely  
Make Required Affidavit  
Mail or Deliver Report to:  
Conservation Division  
State Corporation Commission  
212 No. Market  
Wichita, Kansas

WELL PLUGGING RECORD

Barton County, Sec. 3 Twp. 20, Rge. 11 (D) (W)

Location as "NE/CNW/SW" or footage from lines SE NE SE  
Lease Owner Bergman Oil Company  
Lease Name Panning Well No. 2  
Office Address 425 Union Center Wichita, Kansas  
Character of Well (completed as Oil, Gas or Dry Hole) \_\_\_\_\_  
Date well completed \_\_\_\_\_ 19\_\_\_\_  
Application for plugging filed \_\_\_\_\_ 19\_\_\_\_  
Application for plugging approved 8-27 1970  
Plugging commenced 9-4 1970  
Plugging completed 9-14 1970  
Reason for abandonment of well or producing formation \_\_\_\_\_

If a producing well is abandoned, date of last production \_\_\_\_\_ 19\_\_\_\_  
Was permission obtained from the Conservation Division or its agents before plugging was commenced? Yes

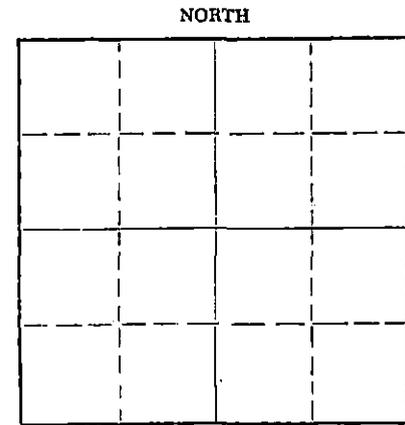

Locate well correctly on above Section Plat

Name of Conservation Agent who supervised plugging of this well Donald Truman  
Producing formation \_\_\_\_\_ Depth to top \_\_\_\_\_ Bottom \_\_\_\_\_ Total Depth of Well 3287 Feet  
Show depth and thickness of all water, oil and gas formations.

OIL, GAS OR WATER RECORDS

CASING RECORD

FORMATION	CONTENT	FROM	TO	SIZE	PUT IN	PULLED OUT
				<u>8 1/2</u>	<u>162</u>	<u>0</u>
				<u>5 1/2</u>	<u>3287</u>	<u>2837'</u>

Describe in detail the manner in which the well was plugged, indicating where the mud fluid was placed and the method or methods used in introducing it into the hole. If cement or other plugs were used, state the character of same and depth placed, from \_\_\_\_\_ feet to \_\_\_\_\_ feet for each plug set.

Filled with sand from 3287' to 3271'; Run 5 sack from 3271' to 3236', run 5 gal. of sand 3236' to 3231'.  
Pumped 15 sacks of gel mud & 90 sacks of cement to plug well.

RECEIVED  
STATE CORPORATION COMMISSION  
SEP 29 1970  
CONSERVATION DIVISION  
Wichita, Kansas  
9-29-70

Name of Plugging Contractor Glenn & Smith Pipe Pulling Co.  
Address Box 156 Ellinwood, Kansas

STATE OF KANSAS, COUNTY OF SEDGWICK, ss.  
Harold Bergman (employee of owner) or (owner or operator) of the above-described well, being first duly sworn on oath, says: That I have knowledge of the facts, statements, and matters herein contained and the log of the above-described well as filed and that the same are true and correct. So help me God.

(Signature) [Signature]  
425 Union Center, Wichita, Kansas 67202  
(Address)

SUBSCRIBED AND SWORN TO before me this 21st day of September, 1970

My commission expires May 9, 1971  
Betty Brandt Notary Public.

15.069.14323.0000

RECEIVED  
STATE CORPORATION COMMISSION

AUG 27 1970

CONSERVATION DIVISION  
Wichita, Kansas

WELL LOG

Company - Jay Bergman Oil Company  
Contractor - Pabco Drilling, Inc.  
Farm - Panning No.2

Sec. 3 T 20 R 11  
SE NE SE

Total Depth 3287'  
Comm. 3-22-49 Comp. 3-29-49

County - Barton  
Kansas

CASING:

8-5/8" 162' Cem. w 175 sx  
5-1/2" 3287' Cem. w 75 sx

Figures indicate Bottom of Formations

Sand & gravel	40
Sand	75
Shale & Shells	162
Shale & redbed	410
Shale & redbed	490
Anhydrite	520
Shale & redbed	1000
Salt & shale	1135
Salt & shale	1250
Shale	1320
Lime	1425
Lime & sand & shale	1440
Lime	1610
Lime	1740
Lime & shale	1815
Lime & shale	1960
Shale & lime	2130
Shale & lime	2405
Shale & lime	2585
Lime	2685
Lime	2790
Lime	2885
Shale & lime	3035
Lime	3050
Lime & shale	3135
Lime & shale	3220
Lime & shale	3287