


WELL PLUGGING RECORD

Give All Information Completely  
Make Required Affidavit  
Mail or Deliver Report to:  
Conservation Division  
State Corporation Commission  
800 Blüding Building  
Wichita, Kansas

NORTH

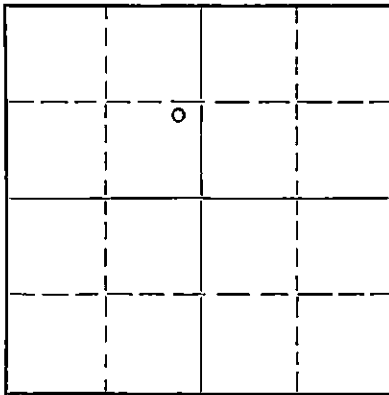

Locate well correctly on above  
Section Plat

Barton County. Sec. 3 Twp. 20 Rge. 11W (E) (W)  
Location as "NE/CNW $\frac{1}{4}$ SW $\frac{1}{4}$ " or footage from lines NE SE NW  
Lease Owner Bergman Oil Company  
Lease Name Dick Well No. 3  
Office Address 201 Union National Bank Bldg., Wichita, Kansas  
Character of Well (completed as Oil, Gas or Dry Hole) Dry Hole  
Date well completed June 30, 1950 19  
Application for plugging filed September 29, 1950 (verbal) 19  
Application for plugging approved October 9, 1950 19  
Plugging commenced October 2, September 29, 1950 19  
Plugging completed October 7, 1950 19  
Reason for abandonment of well or producing formation Dry Hole  
If a producing well is abandoned, date of last production NONE 19  
Was permission obtained from the Conservation Division or its agents before plugging was commenced? Yes

Name of Conservation Agent who supervised plugging of this well C. D. Stough  
Producing formation Depth to top Bottom Total Depth of Well 3327 Feet  
Show depth and thickness of all water, oil and gas formations.

OIL, GAS OR WATER RECORDS

CASING RECORD

Formation	Content	From	To	Size	Put In	Pulled Out
				8-5/8"	160	
				5-1/2"	3309	2776'9"

Describe in detail the manner in which the well was plugged, indicating where the mud fluid was placed and the method or methods used in introducing it into the hole. If cement or other plugs were used, state the character of same and depth placed, from.....feet to.....feet for each plug set.

3150 to 3130 feet Filled with sand.  
3130 to 3100 feet 5 sacks of cement  
3100 to 170 feet Mudded  
170 to 155 feet Rock bridge  
155 to 115 feet 15 sacks of cement  
115 to 30 feet Mudded.  
30 to Cellar 10 sacks of cement.

(If additional description is necessary, use BACK of this sheet)

Correspondence regarding this well should be addressed to Bergman Oil Company,  
Address 201 Union National Bank Bldg.,  
Wichita, Kansas

STATE OF KANSAS, COUNTY OF SEDGWICK, ss.  
Jay Bergman

(employee of owner) or (owner or operator) of the above-described well,  
being first duly sworn on oath, says: That I have knowledge of the facts, statements, and matters herein contained and the log of the above-described well as filed and that the same are true and correct. So help me God.

(Signature) Jay Bergman  
201 Union National Bank Bldg., Wichita, Kans.  
(Address)

SUBSCRIBED AND SWORN to before me this 19<sup>th</sup> day of February 1951

January 31, 1953

My commission expires.....

28-8278-s 4-50-10M

RECEIVED  
STATE CORPORATION COMMISSION  
FEB 19 1951 2-19-51  
Conservation Division  
Wichita, Kansas

PLUGGING  
FILE SEC 3 T 20 R 11W  
BOOK PAGE 33 LINE 26

WELL LOG BUREAU-- KANSAS GEOLOGICAL SOCIETY

508 E. Murdock Wichita, Kansas


Company - JAY BERGMAN OIL COMPANY  
 Farm - Dick No. 3

SEC. 3 T. 20 R.11W  
 NE SE NW

Total Depth. 3309  
 Comm. 10-22-49 Comp. 10-29-49  
 Shot or Treated. 1000 acid  
 Contractor. Fabco Drlg. Inc.  
 Issued. 7-22-50

County. Barton

KANSAS

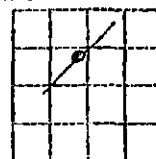

Elevation. \_\_\_\_\_

Production. Dry

CASING:

8 5/8" 160' com. w/125 sx  
 5 1/2" 3309' com. w/75 sx

Figures Indicate Bottom of Formations.

surface clay	10
sand	110
shale & sholls	156
redbed & shalo	515
anhydrite	535
shale & sholls	950
salt & shalo	1350
shale & lime	1500
limo	1800
limo & shale	2050
shale	2250
shale & limo	2475
limo	2995
shale & limo	3065
lime	3306
conglomerate	3308
ar buckle	3309
Total depth	

Tops: Scout  
 Lansing 3048

**PLUGGING**  
 FILE SEC 3 T. 20 R. 11W

33 76

**RECEIVED**  
 STATE CORPORATION COMMISSION  
 MAR 21 1951  
 CONSERVATION DIVISION  
 Wichita, Kansas