


WELL PLUGGING RECORD

Give All Information Completely
Make Required Affidavit
Mail or Deliver Report to:
Conservation Division
State Corporation Commission
211 No. Broadway
Wichita, Kansas

NORTH

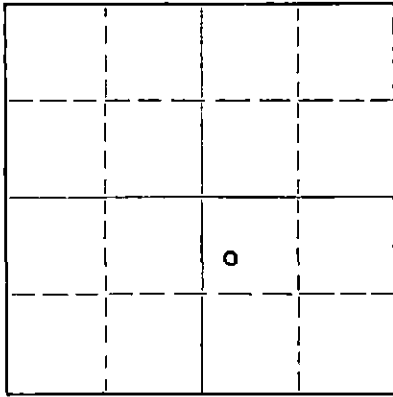

Locate well correctly on above
Section Plat

Barton County. Sec. 11 Twp. 20 Rge. 11 (~~EXX~~) (W)
Location as "NE/CNW/SW" or footage from lines SW NW SE
Lease Owner Stanolind Oil and Gas Company
Lease Name G. Stueckemann Well No. 9
Office Address Box 1654, Oklahoma City, Oklahoma
Character of Well (completed as Oil, Gas or Dry Hole) Oil
Date well completed 9-9- 19 39
Application for plugging filed 3-6- 19 56
Application for plugging approved 3-7- 19 56
Plugging commenced 4-5- 19 56
Plugging completed 4-15- 19 56
Reason for abandonment of well or producing formation Economically Depleted

If a producing well is abandoned, date of last production March 19 56
Was permission obtained from the Conservation Division or its agents before plugging was commenced? Yes

Name of Conservation Agent who supervised plugging of this well R. M. Brundage
Producing formation Arbuckle Depth to top 3285 Bottom 3291 Total Depth of Well 3291 Feet
Show depth and thickness of all water, oil and gas formations.

OIL, GAS OR WATER RECORDS

CASING RECORD

FORMATION	CONTENT	FROM	TO	SIZE	PUT IN	PULLED OUT
<u>Arbuckle</u>	<u>Water</u>	<u>3285</u>	<u>3291</u>	<u>8-5/8</u>	<u>210</u>	<u>None</u>
				<u>5-1/2</u>	<u>3305</u>	<u>2374</u>

Describe in detail the manner in which the well was plugged, indicating where the mud fluid was placed and the method or methods used in introducing it into the hole. If cement or other plugs were used, state the character of same and depth placed, from _____ feet to _____ feet for each plug set.

Dumped Sand 3291-3278
5 Sx Cement 3278-3245
Mudded 3245- 225
Crushed Rock 225 - 215
20 Sx Cement 215- 155
Mudded 155 - 35
Crushed Rock and 10 Sx Cement 35 to Base of Collar

(If additional description is necessary, use BACK of this sheet)

Name of Plugging Contractor West Supply Company
Address Chase, Kansas


STATE OF KANSAS, COUNTY OF BARTON, ss.
I, G. A. Reynolds (employee of owner) or (owner) of the above-described well, being first duly sworn on oath, says: That I have knowledge of the facts, statements, and matters herein contained and the log of the above-described well as filed and that the same are true and correct. So help me God.

(Signature) G. Reynolds
Box 7, Ellinwood, Kansas
(Address)

SUBSCRIBED AND SWORN TO before me this 17th day of April, 19 56.

My commission expires November 12, 1958

Notary Public.

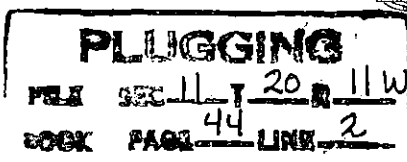

APR 18 1956
CONSERVATION DIVISION
Wichita, Kansas

STANOLIND OIL AND GAS COMPANY

640 Acres

N ~~E-11-X~~

	160				160
	160				160

Locate Well Correctly

WELL RECORD

COUNTY Barton, SEC. 11, TWP. 20 S, RGE. 11 W
 COMPANY OPERATING Stanolind Oil and Gas Company
 OFFICE ADDRESS Box 991, Tulsa, Oklahoma
 FARM NAME G. Stueckmann WELL NO. 9
 DRILLING STARTED 8-5 19 39, DRILLING FINISHED 9-7 19 39
 WELL LOCATED S $\frac{1}{4}$ SW $\frac{1}{4}$ SE $\frac{1}{4}$ 1650 ft. North of South
 Line and 330 ft. East of West Line of Quarter Section.
 ELEVATION (Relative to sea level) DERRICK FLR. 1755' GROUND 1753'
 CHARACTER OF WELL (Oil, gas or dry hole) Oil

OIL OR GAS SANDS OR ZONES

Name	From	To	Name	From	To
1 <u>Arbuckle Dolomite</u>	<u>3285</u>	<u>3291</u>			
2					
3					

WATER SANDS

Name	From	To	Water Level	Name	From	To	Water Level
1							
2							
3							

CASING RECORD

Size	Wt.	Thds.	Make	Amount Set		Amount Pulled		Packer Record			
				Ft.	In.	Ft.	In.	Size	Length	Depth Set	Make
<u>8-5/8"</u>	<u>32</u>	<u>8</u>	<u>Used</u>	<u>209</u>	<u>3</u>	<u>(Thds. off - landed at 219'3")</u>					
<u>5-1/2"</u>	<u>14</u>	<u>8</u>	<u>Mixed</u>	<u>3282</u>	<u>2</u>	<u>(Thds. off - landed at 3286'6")</u>					

Liner Record: Amount _____ Kind _____ Top _____ Bottom _____

CEMENTING AND MUDDING RECORD

Size	Amount Set		Sacks Cement	Chemical		Method Cementing	Amount	Mudding Method	Results (See Note)
	Feet	In.		Gal.	Make				
<u>8-5/8"</u>	<u>210</u>	<u>2</u>	<u>125</u>	<u>(Oilmax)</u>		<u>Halliburton</u>			
<u>5-1/2"</u>	<u>3305</u>	<u>1</u>	<u>75</u>	<u>(Atlas)</u>		<u>Halliburton</u>			

NOTE: What method was used to protect sands when outer strings were pulled?

NOTE Were bottom hole plugs used? _____ If so, state kind, depth set and results obtained _____

PLUGGING
 PER SEC 11 T 20 R 11W
 ROCK FACE 44 LINE 2

TOOLS USED

Rotary tools were used from 0 feet to 3290 feet, and from _____ feet to _____ feet
 Cable tools were used from 3290 feet to 3291 feet, and from _____ feet to _____ feet
 Type Rig 9 1/2" Steel

PRODUCTION DATA

Production first 24 hours _____ bbls. Gravity _____ Emulsion _____ per cent., Water _____ per cent.
Modified Potential 1663 bbls. oil, no water, per day using Depthograph fluid level measurements.
 Production second 24 hours _____ bbls. Gravity _____ Emulsion _____ per cent., Water _____ per cent.
 If gas well, cubic feet per 24 hours _____ Rock Pressure, lbs. per square inch _____

I, the undersigned, being first duly sworn upon oath, state that this well record is true, correct and complete according to the records of this office and to the best of my knowledge and belief.

C. L. Kern Prod. Foreman
 Name and Title

Subscribed and sworn to before me this the 12th day of September, 193 9

My commission expires May 3, 1941

Joan H. Wilcox
 Notary Public.

FORMATION RECORD

Give detailed description and thickness of all formations drilled through and contents of sand, whether dry, water, oil or gas.

Formation	Top	Bottom	Formation	Top	Bottom
Cellar	0	6	<u>CABLE TOOLS -</u>		
Sand	6	60	Made while cleaning out	3290	3291
Shale and Shells	60	250			
Red Beds	250	490	Loaded hole with 1500' oil;		
Anhydrite	490	510	Filled to 2900' and flowed		
Shale	510	890	while drilling plug.		
Shale and Shells	890	1260			
Red Rock and Shale	1260	1519	<u>Swab Test</u>		
Shale and Lime Shells	1519	1641	600' from top - 2-hr. test - 9.52 B.P.H.		
Shale Sandy	1641	1675	800' from top - 2-hr. test - 15.17 B.P.H.		
Shale and Shells	1675	1770			
Red Bed - Lime	1770	1901	<u>Acid</u>		
Shale and Lime Shells	1901	2095	September 7, 1939, with		
Shale	2095	2150	1000 gallons Chemical		
Sandy Lime, Shale Breaks	2150	2209	Process acid.		
Shale and Shells	2209	2559			
Shale	2559	2597	<u>Swab Test</u>		
Lime	2597	2607	600' from top - 2-hr. test - 9.5 B.P.H.		
Shale	2607	2637	800' from top - 2-hr. test - 16.5 B.P.H.		
Lime	2637	2947			
Lime and Shale	2947	3022	<u>Total Depth</u>		3291
Lime	3022	3069	<u>Modified Potential Test</u>		
Broken Lime	3069	3110	High Rate 486.36 B.P.D. @ 2148.9' from bottom.		
Lime	3110	3198	Intermediate Rate 361.32 B.P.D. @ 2359' from Btm.		
Shale	3198	3205	Low Rate 172.92 B.P.D. @ 2708.2' from bottom.		
Lime, soft brown; smell	3205	3218	<u>Potential - 1662.70 BBLs. per day.</u>		
of oil	3218	3250			
Lime, very hard	3218	3250			
Broken Lime and Shale	3250	3267			
Lime	3267	3285			
<u>Top Artucle</u>	3285				
Dolomite	3285	3291			
<u>Total Depth</u>	3291				
Following Information for			Date First Work		8-2-39
Stanolind Copies of Well			Date Drilling Commenced		8-6-39
Record only:			Date Drilling Completed		9-7-39
			Date Well Completed		9-9-39
			Date Potential Effective		9-10-39
<u>Core #1 15' 15' Rec.</u>					
Lime, tan, dense,	3267	3268			
Shale, green	3268	3269			
Lime, brown, broken	3269	3270			
Shale, gray to black,					
hard blocky	3270	3274			
Lime, tan, dense, with					
thin gray shale partings.	3274	3282			
<u>Core #2 6' 9" 8' Rec.</u>					
Lime, tan, dense, with					
thin gray shale streaks	3282	3283 1/2			
Shale, gray-green, crumbly	3283 1/2	3284 1/2			
Shale, dark gray, sandy,					
hard	3284 1/2	3285			
Dolomite, tan, m.x. to					
c.x.; good spotted po-					
rosity 3286-90 with fair					
saturation. Best satu-					
ration bottom 6" of core.	3285	3290			