


WELL PLUGGING RECORD

Give All Information Completely  
Make Required Affidavit  
Mail or Deliver Report to:  
Conservation Division  
State Corporation Commission  
800 Bittling Building  
Wichita, Kansas

NORTH

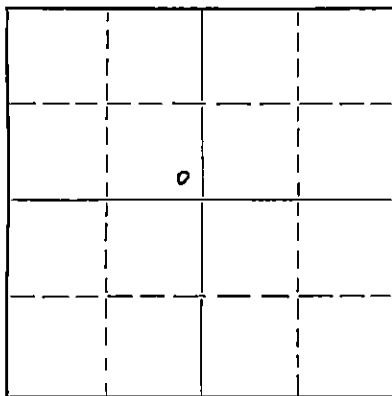

Locate well correctly on above  
Section Plat

Barton County, Sec. 11 Twp. 20S Rge. 11 (S) (W)  
Location as "NE/CNW $\frac{1}{4}$ /SW $\frac{1}{4}$ " or footage from lines SE $\frac{1}{4}$ , SE $\frac{1}{4}$ , NW $\frac{1}{4}$   
Lease Owner Stanolind Oil and Gas Company  
Lease Name F. Panning Well No. 6  
Office Address P.O. Box 1654, Oklahoma City, Oklahoma  
Character of Well (completed as Oil, Gas or Dry Hole) Oil  
Date well completed 11-25 1937  
Application for plugging filed 4-10 1950  
Application for plugging approved 4-12 1950  
Plugging commenced 4-22 1950  
Plugging completed 4-30 1950  
Reason for abandonment of well or producing formation Depleted

If a producing well is abandoned, date of last production February 1949  
Was permission obtained from the Conservation Division or its agents before plugging was commenced? Yes

Name of Conservation Agent who supervised plugging of this well C. D. Stough  
Producing formation Siliceous Lime Depth to top 3274 Bottom 3290 Total Depth of Well 3290 Feet  
Show depth and thickness of all water, oil and gas formations.

OIL, GAS OR WATER RECORDS

CASING RECORD

Formation	Content	From	To	Size	Put In	Pulled Out
Siliceous Lime	Oil	3274	3290	10 3/4 6	214 3295	None 2603

Describe in detail the manner in which the well was plugged, indicating where the mud fluid was placed and the method or methods used in introducing it into the hole. If cement or other plugs were used, state the character of same and depth placed, from.....feet to.....feet for each plug set.

Dumped Crushed Rock 3290' - 3269'  
6 sx. Cement 3269' - 3250' Pumped Hvy. Mud 150' - 30'  
Pumped Hvy. Mud 3250' - 210' 10 sx. Cement 30' - 10' Bottom Cellar  
Dumped Crushed Rock 210' - 150'  
20 sx. Cement 190' - 150'

(If additional description is necessary, use BACK of this sheet)

Correspondence regarding this well should be addressed to G. A. Younie  
Address P.O. Box 7, Ellinwood, Kansas

STATE OF Kansas, COUNTY OF Barton, ss.  
G. A. Younie (employee of owner) or (owner or operator) of the above-described well,  
being first duly sworn on oath, says: That I have knowledge of the facts, statements, and matters herein contained and the log of the above-described well as filed and that the same are true and correct. So help me God.

(Signature) *G. A. Younie*  
P.O. Box 7, Ellinwood, Kansas  
(Address)

SUBSCRIBED AND SWORN to before me this 4th day of May 19 50.

My commission expires November 14, 1953

22-7377-3 4-49-10M

*[Signature]*  
Notary Public.  
Conservation Div.  
MAY 5 - 1950 5-5-50  
PLUGGING  
FILE SEC-11 T-20 R-160  
BOOK PAGE 147 LINE 43  
CORPORATION  
COMMISSION  
KANSAS

## FORMATION RECORD

DESCRIBE EACH FORMATION DRILLED. INDICATE THICKNESS. CONTENT AND WHETHER DRY, OR OIL, GAS, OR WATER BEARING.

FORMATION	TOP	BOTTOM	FORMATION	TOP	BOTTOM
Sand, shells, and shale	0	212			
Shale and red rock	212	485			
Anhydrite	485	510			
Shale and shells	510	1000			
Salt	1000	1200			
Shale and shells	1200	1370			
Lime	1370	1400			
Shale and shells	1400	1665			
Sand	1665	1680			
Broken lime	1680	1950			
Shale and lime	1950	2170			
Broken lime	2170	2228			
Shale and shells	2228	2360			
Lime	2360	2385			
Shale and shells	2385	2499			
Broken lime and lime	2499	3005			
Lime	3005	3265			
Shale	3265	3275			
Coring Record					
#1 3275-3285 5'/10' Recovery					
Dol. gray, very porous, good saturation, 4'6", Dol. gray dense, very cherty, little saturation, 6".	3275	3285			
Top Siliceous	3274				
Cable Tool Cores					
Cleaning out to bottom	3285	3288			
Lime-fair saturation	3288	3290			
Total Depth	3290				
Acidizing Record					
Acidized with 2000 gallons Dowell XX treatment in 51 minutes	11-25-37				
Date of first work	10-9-37				
Date drilling commenced	10-21-37				
Date drilling completed	11-25-37				
Date of completion	11-27-37				
Date potential effective	11-28-37				

**PLUGGING**  
FILE SEC-11-T-20R/11W  
BOOK PAGE 147 LINE 15

15.009.14455.0000

STANOLIND OIL AND GAS COMPANY

WELL RECORD

TWP. 20 S N OR S

SUPPLEMENTAL (ENTER "X" WHEN APPLICABLE)

Grid for well location with handwritten numbers #5, 0, 11, 11, W, E OR W

LEASE F. Panning "A" WELL NO. 6

LOCATION OF WELL: 330 FT. NORTH SOUTH OF THE SOUTH LINE AND 2310 FT. EAST WEST OF THE WEST LINE OF THE SE 1/4 SE 1/4 NW 1/4

11 OF SECTION 11 TOWNSHIP 20 NORTH SOUTH RANGE 11 EAST WEST

W Barton COUNTY Kansas STATE

ELEVATION: Derrick Flr. 1759 Ground 1756

COMPLETED AS: X OIL WELL GAS WELL WATER WELL DRY HOLE

DRILLING: COMMENCED 10-21 19 37 COMPLETED 11-25 19 37

LOCATE WELL CORRECTLY

OPERATING COMPANY Stanolind Oil and Gas Company ADDRESS Box 591, Tulsa, Oklahoma

OIL OR GAS SANDS OR ZONES

Table with columns: NAME, FROM, TO, NAME, FROM, TO. Row 1: Siliceous Lime, 3274, 3290, 4, 5, 6

WATER SANDS

Table with columns: NAME, FROM, TO, WATER LEVEL, NAME, FROM, TO, WATER LEVEL. Rows 1, 2

CASING RECORD (OVERALL MEASUREMENT)

LINER SCREEN RECORD

Tables for casing and liner screen records with columns for size, weight, threads, make, grade, quantity, size, and set at.

COPY

PACKER RECORD

Table for packer record with columns: SIZE, LENGTH, SET AT, MAKE AND TYPE

CEMENTING RECORD

MUDDING RECORD

Tables for cementing and mudding records with columns for size, where set, cement, method, final press, method, results.

COPY

WHAT METHOD WAS USED TO PROTECT SANDS WHEN OUTER STRINGS WERE PULLED?

WERE BOTTOM HOLE PLUGS USED?

IF SO, STATE KIND, DEPTH SET, AND RESULTS OBTAINED

ROTARY TOOLS WERE USED FROM 0 FEET TO 3285 FEET, AND FROM FEET TO FEET

CABLE TOOLS WERE USED FROM 3285 FEET TO 3290 FEET, AND FROM FEET TO FEET

24-HOUR PRODUCTION OR POTENTIAL TEST Swabbed 37 bbls. oil per hour, before acidizing thru 6" casing

8 hr. state test 1623 bbls. oil, no water, pumping 36-54" SPM Thru 3" Tubing 6" BBLs.

IF GAS WELL, CUBIC FEET PER 24 HOURS SHUT-IN PRESSURE LBS. PER SQUARE IN.

I, THE UNDERSIGNED, BEING FIRST DULY SWORN UPON OATH, STATE THAT THIS WELL RECORD IS TRUE AND CORRECT ACCORDING TO THE RECORDS OF THIS OFFICE AND TO THE BEST OF MY KNOWLEDGE AND BELIEF.

SUBSCRIBED AND SWORN TO BEFORE ME THIS DAY OF MY COMMISSION EXPIRES

MAY 6 - 1950 NAME AND TITLE STATE CORPORATION NOTARY PUBLIC USION KANSAS