

STATE OF KANSAS
STATE CORPORATION COMMISSION

WELL PLUGGING RECORD

15-009-22245-000

Give All Information Completely
Make Required Affidavit
Mail or Deliver Report to
Conservation Division
State Corporation Comm.,
245 North Water
Wichita, KS 67202

Barton County, Sec. 12 Twp. 16S Rge. 13 E/W
Location as "NE/CNW $\frac{1}{4}$ SW $\frac{1}{4}$ " or footage from lines

C NE NE

Lease Owner Abraxas Petroleum Corporation
Lease Name William Miller Well No. #1
Office Address 1100 N.E. Loop 410, San Antonio, Tex. 78217
Character of Well (Completed as Oil, Gas or Dry Hole)

Dry Hole

Date Well completed 3-4-81 19
Application for plugging filed 3-4-81 19
Application for plugging approved 3-4-81 19
Plugging commenced 3-4-81 19
Plugging completed 3-4-81 19


Reason for abandonment of well or producing formation
Commercial quantities of oil not found

If a producing well is abandoned, date of last production
19

Was permission obtained from the Conservation Division or
its agents before plugging was commenced? Yes

Name of Conservation Agent who supervised plugging of this well Gilbert Tolman
Producing formation _____ Depth to top _____ Bottom _____ Total Depth of Well 3440'

Show depth and thickness of all water, oil and gas formations.

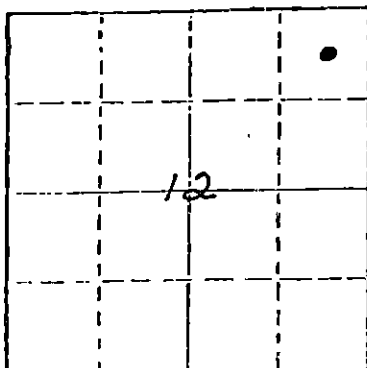

Locate well correctly on above
Section Plat

OIL, GAS OR WATER RECORDS

CASING RECORD

FORMATION	CONTENT	FROM	TO	SIZE	PUT IN	PULLED OUT
				8 5/8"	248'	None

Describe in detail the manner in which the well was plugged, indicating where the mud fluid
was placed and the method or methods used in introducing it into the hold. If cement or other
plugs were used, state the character of same and depth placed, from _____ feet to
_____ feet for each plug set.

Plug @ 600' w/50 sx.

Plug @ 245' w/25 sx.

Plug @ 40' w/10 sx.

Rat Hole . 5 sx.

5-26-81

RECEIVED

STATE CORPORATION COMMISSION

MAY 26 1981

(If additional description is necessary, use BACK of this sheet)

Name of Plugging Contractor Rains & Williamson Oil Co., Inc. CONSERVATION DIVISION
Wichita, Kansas

STATE OF Kansas COUNTY OF Sedgwick, ss.
Wilson Rains, President of Rains & Williamson Oil Co., Inc. (employee of owner) or (owner or operator)
of the above-described well, being first duly sworn on oath, says: That I have knowledge of
the facts, statements, and matters herein contained and the log of the above-described well
as filed and that the same are true and correct. So help me God.

(Signature) Wilson Rains

435 Page Court, 220 W. Douglas, Wichita, Ks. 67202
(Address)

SUBSCRIBED AND SWORN TO before me this 13 day of March, 19 81

Juanita M. Green
Juanita M. Green Notary Public.

My commission expires

10-4-83



15-009-22245-0000

DRILLER'S LOG

COMPANY: Abraxas Petroleum Corporation

SEC. 12 T. 16S R. 13W

WELL NAME: William Miller #1

LOC. C NE NE

COUNTY: Barton

RIG NO. #9

TOTAL DEPTH 3440'

ELEVATION 1900 GR

COMMENCED: 2-21-81 COMPLETED: 3-4-81

CONTRACTOR: Rains & Williamson Oil Co., Inc.

CASING RECORD:

SURFACE: 8 5/8" @ 248' w/200 sx. 50/50 poz., 2% gel, 3% cc.

PRODUCTION: D&A

LOG

(Figures Indicate Bottom of Formations)

Redbed	313
Shale	1600
Lime & Shale	3160
Shale & Lime	3440
<u>ROTARY TOTAL DEPTH</u>	<u>3440</u>

RECEIVED
STATE CORPORATION COMMISSION

MAY 26 1981

CONSERVATION DIVISION
Wichita, Kansas

STATE OF Kansas
COUNTY OF Sedgwick

SS:

I, Wilson Rains, President of Rains & Williamson Oil Co., Inc.
upon oath state that the above and foregoing is a true and correct copy of the log of the
William Miller #1 well.

Wilson Rains
Wilson Rains

Subscribed and sworn to before me this 13 day of March, 1981.

My Appointment Expires:
10-4-83

Juanita M. Green
Juanita M. Green

