


15-009-00868-0000

STATE OF KANSAS
STATE CORPORATION COMMISSION

WELL PLUGGING RECORD

Give All Information Completely
Make Required Affidavit
Mail or Deliver Report to:
Conservation Division
State Corporation Commission
800 Bitting Building
Wichita, Kansas

Barton County. Sec. 12 Twp. 16 Rge. (E) 13 (W)
Location as "NE/CNW $\frac{1}{4}$ /SW $\frac{1}{4}$ " or footage from lines NEc. SE. SE
Lease Owner D.R. Lauck Oil Company Inc.
Lease Name Whitmer Well No. 1
Office Address 301 South Broadway Wichita 2 Kansas
Character of Well (completed as Oil, Gas or Dry Hole) dry hole
Date well completed June 2 19.50
Application for plugging filed June 2 19.50
Application for plugging approved June 2 19.50
Plugging commenced June 2 19.50
Plugging completed June 2 19.50
Reason for abandonment of well or producing formation dry hole
If a producing well is abandoned, date of last production 19.
Was permission obtained from the Conservation Division or its agents before plugging was commenced? yes

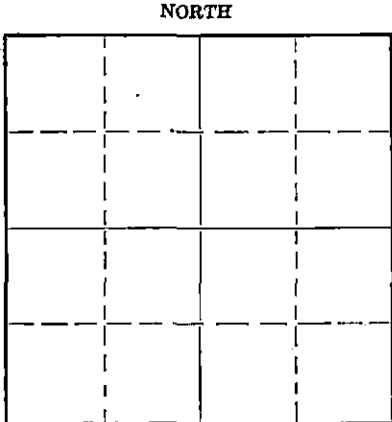

Locate well correctly on above Section Flat

Name of Conservation Agent who supervised plugging of this well Stough
Producing formation none Depth to top Bottom Total Depth of Well 3396 Feet
Show depth and thickness of all water, oil and gas formations.

OIL, GAS OR WATER RECORDS

CASING RECORD

Formation	Content	From	To	Size	Put In	Pulled Out
Arbuckle	Water	3374	3396	10"	203'	none

Describe in detail the manner in which the well was plugged, indicating where the mud fluid was placed and the method or methods used in introducing it into the hole. If cement or other plugs were used, state the character of same and depth placed, from feet to feet for each plug set.

mud 3396-200
bridge 200-195
cement 195-155
mud 155-31
bridge 31-26
cement 26-6 bottom of cellar

6-7-50
RECEIVED
Conservation Div.
JUN 7 X 1950
CONSERVATION
DIVISION
KANSAS

(If additional description is necessary, use BACK of this sheet)
Correspondence regarding this well should be addressed to D.R. Lauck Oil Company Inc.
Address 301 South Broadway Wichita 2 Kansas

STATE OF Kansas, COUNTY OF Sedgwick, ss.
P. R. Bishop (employee of owner) or (owner or operator) of the above-described well,
being first duly sworn on oath, says: That I have knowledge of the facts, statements, and matters herein contained and the log of the above-described well as filed and that the same are true and correct. So help me God.
(Signature) [Signature]
Wichita, Kansas (Address)

SUBSCRIBED AND SWORN TO before me this 7th day of June, 19.50
Elizabeth Kay Notary Public

My commission expires Sept. 14, 1951 22-5133-9 9-48-10M

PLUGGING
FILE SEC 12 T 16 R 13 W
BOOK PAGE 9 LINE 43

15-009-00808-0000

D. R. LAUCK OIL COMPANY INC.

Whitmer No. 1
NEc SE SE

Sec. 12 Twp. 16S. R 13W.
Barton County Kansas

Commenced May 22, 1950

Completed June 2, 1950

Casing:
10" 203' cemented 150 sacks

shale & shells	175
sand	185
shale & shells	200
red rock & shells	310
shale & shells	155
sand	185
shale & shells	215
Anhydrite	875
shale & shells	1080
shale & lime	2560
Lime	2565
Lime & shale	2650
shale	2705
Lime & shale	2740
Lime	2834
shale & lime	2903
Lime	2955
Lime & shale	3020
Lime	3398

Tops- Derrick floor

Heebner	3015
Brown lime	3100
White Lime	3115
Arbuckle	3374
Total Depth	3396

RECEIVED

Conservation Div.

JUN 9 X 1950

STATE CORPORATION
COMMISSION

KANSAS

PLUGGING
 FILE SEC 12 T 16 R 13W
 BOOK PAGE 9 LINE 43