


Give All Information Completely  
Make Required Affidavit  
Mail or Deliver Report to:  
Conservation Division  
State Corporation Commission  
211 No. Broadway  
Wichita, Kansas

WELL PLUGGING RECORD

NORTH

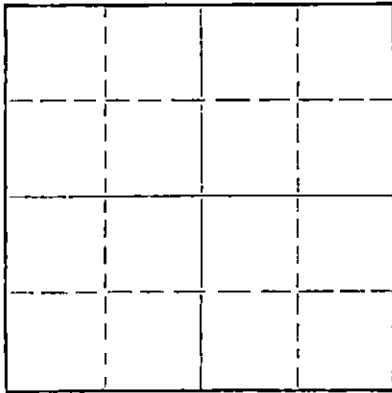

Locate well correctly on above  
Section Plat

Barton County. Sec. 12 Twp. 16 Rge. 13 (E) W (W)  
Location as "NE/CNW%SW%" or footage from lines NE NE SW  
Lease Owner Fender Pipe & Supply  
Lease Name Phillips Well No. 1  
Office Address Russell, Kansas  
Character of Well (completed as Oil, Gas or Dry Hole) \_\_\_\_\_  
Date well completed \_\_\_\_\_ 19\_\_\_\_  
Application for plugging filed \_\_\_\_\_ 19\_\_\_\_  
Application for plugging approved \_\_\_\_\_ 19\_\_\_\_  
Plugging commenced Dec. 27 19 65  
Plugging completed Jan. 3 19 66  
Reason for abandonment of well or producing formation \_\_\_\_\_

If a producing well is abandoned, date of last production \_\_\_\_\_ 19\_\_\_\_  
Was permission obtained from the Conservation Division or its agents before plugging was commenced? yes

Name of Conservation Agent who supervised plugging of this well truon  
Producing formation \_\_\_\_\_ Depth to top \_\_\_\_\_ Bottom \_\_\_\_\_ Total Depth of Well 3435 Feet  
Show depth and thickness of all water, oil and gas formations.

OIL, GAS OR WATER RECORDS

CASING RECORD

FORMATION	CONTENT	FROM	TO	SIZE	PUT IN	PULLED OUT

Describe in detail the manner in which the well was plugged, indicating where the mud fluid was placed and the method or methods used in introducing it into the hole. If cement or other plugs were used, state the character of same and depth placed, from 3435 feet to surface feet for each plug set.

Sanded up to 3100' dump 5 sacks of cement on bottom.

Pulled pipe set rock bridge at 300' dump 5 sacks of cement on bridge bailed hole down & filled hole with ready-mix cement.

Well completed.

RECEIVED  
STATE CORPORATION COMMISSION

JAN 25 1966

CONSERVATION DIVISION  
Wichita, Kansas

1-25-66

(If additional description is necessary, use BACK of this sheet)

Name of Plugging Contractor Barnes & Sons Pipe Pulling Co.  
Address P.O. Box 313 Russell, Kansas

STATE OF Kansas, COUNTY OF Russell, ss.

Allen T. Fender (employee of owner) or (owner or operator) of the above-described well, being first duly sworn on oath, says: That I have knowledge of the facts, statements, and matters herein contained and the log of the above-described well as filed and that the same are true and correct. So help me God.

(Signature) Allen T. Fender  
Box 302, Russell, Kansas  
(Address)

SUBSCRIBED AND SWORN TO before me this 24<sup>th</sup> day of January, 1966

My commission expires September 27, 1967

Notary Public.