

WELL PLUGGING RECORD

Give All Information Completely
Make Required Affidavit
Mail or Deliver Report to:
Conservation Division
State Corporation Commission
211 No. Broadway
Wichita, Kansas

Barton County. Sec. 11 Twp. 16 Rge. (E) 13 (W)

Location as "NE/CNW/SW" or footage from lines SW SW NW

Lease Owner Morgenstern & Specter

Lease Name Ehrlich Well No. 1

Office Address Box 661 Russell, Kansas

Character of Well (completed as Oil, Gas or Dry Hole) Dry hole

Date well completed April 12 1959

Application for plugging filed April 14 1959

Application for plugging approved _____ 19____

Plugging commenced 4 p.m. April 12 1959

Plugging completed 7 p.m. " " 1959

Reason for abandonment of well or producing formation Dry hole


If a producing well is abandoned, date of last production _____ 19____

Was permission obtained from the Conservation Division or its agents before plugging was commenced? yes

Name of Conservation Agent who supervised plugging of this well Mr. Don Truan

Producing formation _____ Depth to top _____ Bottom _____ Total Depth of Well 3388 Feet

Show depth and thickness of all water, oil and gas formations.

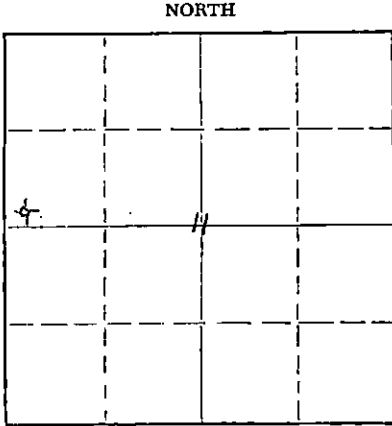

Locate well correctly on above Section Plat

OIL, GAS OR WATER RECORDS

CASING RECORD

FORMATION	CONTENT	FROM	TO	SIZE	PUT IN	PULLED OUT
				8 5/8"	251'	none

Describe in detail the manner in which the well was plugged, indicating where the mud fluid was placed and the method or methods used in introducing it into the hole. If cement or other plugs were used, state the character of same and depth placed, from _____ feet to _____ feet for each plug set.

Bottom plug set at 240', $\frac{1}{4}$ sack of hulls, 25 sacks of cement, mud up to 40'.
Top plug at 40', $\frac{1}{2}$ sack of hulls, 10 sacks of cement.

4-16-59

RECEIVED
STATE CORPORATION COMMISSION
APR 16 1959
CONSERVATION DIVISION
Wichita, Kansas

(If additional description is necessary, use BACK of this sheet)

Name of Plugging Contractor Triangle Drilling, Inc.

Address Box 287 Russell, Kansas

STATE OF Kansas, COUNTY OF Barton, ss.

Donald D. Vaughan (employee of owner) or (~~owner or operator~~) of the above-described well, being first duly sworn on oath, says: That I have knowledge of the facts, statements, and matters herein contained and the log of the above-described well as filed and that the same are true and correct. So help me God.

(Signature) Donald D. Vaughan

Box 619 Great Bend, Kansas (Address)

SUBSCRIBED AND SWORN TO before me this 14th day of April, 1959

My commission expires April 31, 1961 Dean E. Cooley Notary Public.

PLUGGING
FILE SEC. 11 T. 16 R. 13w
BOOK PAGE 31 LINE 16

15-009-00265-0000

WELL LOG

COMPANY Morgenstern & Specter
 CONTRACTOR Triangle Drilling, Inc.
 FARM #1 Ehrlich
 LOCATION SW SW NW of Section 11-16-13W
 Barton County, Kansas
 ELEVATION 1872 KB
 SURFACE PIPE 8 5/8" cemented at 251' w/175 sacks common
 PRODUCTION D & A
 COMMENCED April 2, 1959
 COMPLETED April 12, 1959

<u>FORMATION</u>	<u>DEPTH</u>	<u>FORMATION</u>	<u>DEPTH</u>
Surface clay	10	Shale and shells	1605
Post rock	30	Limestone and shale	1630
Hard gray shale & limestone	130	Limestone	1730
Shale and shells	180	Broken limestone	1855
Sandstone	195	Limestone	1970
Shale and shells	285	Limestone and shale	2732
Hard sandstone & pyrite	325	Limestone	3038
Shale and shells	545	Shale	3086
Red bed	842	Limestone	3343
Anhydrite	872	Conglomerate	3352
Shale and shells	1095	Dolomite	3388
Shale, shells and salt	1250		

FORMATION TOPS

Anhydrite	842 (-1030)
Topeka	2732 (- 860)
Heebner	3005 (-1133)
Toronto	3024 (-1152)
Brown Limestone	3086 (-1214)
Lansing	3100 (-1228)
Chert Conglomerate	3343 (-1471)
Arbuckle	3352 (-1480)
RTD	3388 (-1516)

RECEIVED
 STATE CORPORATION COMMISSION
 APR 16 1959
 CONSERVATION DIVISION
 Wichita, Kansas

A F F I D A V I T

STATE OF KANSAS, COUNTY OF BARTON, SS.

I, Donald D. Vaughan, of the TRIANGLE DRILLING, INC., being first duly sworn on oath, state; That I have knowledge of the facts, statements and matters herein contained and that the same are true and correct.

Donald D. Vaughan
 Donald D. Vaughan

Subscribed and sworn to before me this 14th day of April, 1959.

PLUGGING
 FILE SEC. 11 T. 16 R. 13W
 BOOK PAGE 31 LINE 16

Dean E. Cooley
 Dean E. Cooley, Notary Public

My Commission expires: April 29, 1961.