

STATE OF KANSAS
STATE CORPORATION COMMISSION


WELL PLUGGING RECORD

OR
FORMATION PLUGGING RECORD

Strike out upper line when reporting plugging of formations.

Give All Information Completely
Make Required Affidavit
Mail or Deliver Report to:
Conservation Division
State Corporation Commission
800 Bitting Building
Wichita, Kansas

Barton County. Sec. 8 Twp. 20 Rge. 11 (E).....(W)
Location as "NE $\frac{1}{4}$ NW $\frac{1}{4}$ SW $\frac{1}{4}$ " or footage from lines..... S/2 SE/4 NW/4
Lease Owner Alpine Oil & Royalty Co., Inc.
Lease Name Duncan "A" Well No. 1
Office Address 300 Bitting Bldg., Wichita, Kansas
Character of Well (completed as Oil, Gas or Dry Hole).....
Date well completed November 29 19 39
Application for plugging filed..... 19
Application for plugging approved..... 19
Plugging commenced..... 19
Plugging completed..... 19
Reason for abandonment of well or producing formation Ceased producing
If a producing well is abandoned, date of last production..... September 29th 19 49
Was permission obtained from the Conservation Division or its agents before plugging was commenced?.....

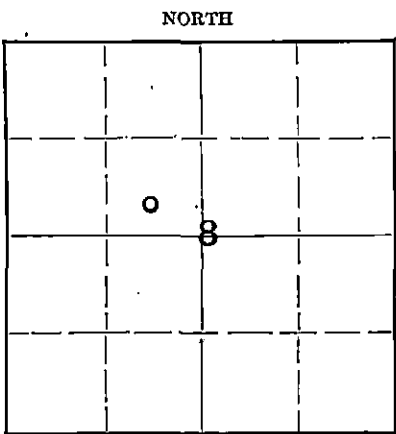

Locate well correctly on above Section Plat

Name of Conservation Agent who supervised plugging of this well.....
Producing formation Arbuckle Depth to top 3297 Bottom 3308 $\frac{1}{2}$ Total Depth of Well 3308 $\frac{1}{2}$ Feet
Show depth and thickness of all water, oil and gas formations.

OIL, GAS OR WATER RECORDS


CASING RECORD

Formation	Content	From	To	Size	Put In	Pulled Out
				10 3/4"	194'	
				5 3/4"	3298'	

Describe in detail the manner in which the well was plugged, indicating where the mud fluid was placed and the method or methods used in introducing it into the hole. If cement or other plugs were used, state the character of same and depth placed, from.....feet to.....feet for each plug set.

2120 to 2100 ft. 5 Sacks cement.
2100 to 200 ft. Mudded.
200 to 210 Rock Bridge.
210 to 170 20 sacks cement.
170 to 30 Mud
30 feet to Cellar 10 sacks cement.

2120 feet was far as could get the tools down, so shoved a plug down there and cemented, as per instructions from the State plugger. 3-28-50

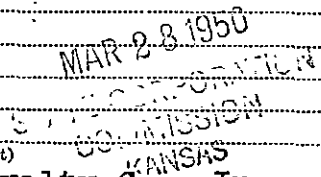

(If additional description is necessary, use BACK of this sheet)

Correspondence regarding this well should be addressed to Alpine Oil & Royalty Co., Inc.
Address 300 Bitting Bldg., Wichita, Kansas

STATE OF Kansas, COUNTY OF Sedgwick, ss.
Dwight J. Wilson (employee of owner) or (owner or operator) of the above-described well,

being first duly sworn on oath, says: That I have knowledge of the facts, statements, and matters herein contained and the log of the above-described well as filed and that the same are true and correct. So help me God.

(Signature) Dwight J. Wilson
300 Bitting Building, Wichita, Kansas
(Address)

SUBSCRIBED AND SWORN to before me this 27th day of March, 19 50

My commission expires August 8, 1953.

Lawrence Allen
Notary Public.
PLUGGING
FILE SEC 8 T 20 R 11 W
BOOK PAGE 37 LINE 45

WELL LOG

Alpine Oil & Royalty Co., Inc.

Contractor: Simpson & Noble

Commenced: 10-31-39

Completed: 11-29-39

Production: 3000 barrels

Acid: 2000 Gals. 11-25-39

Duncan "A" 1

S/2 SE NW

Section 8-20S-11W

Barton County, Kansas

Elevation: 1779'

Casing Record: 194' 10 3/4"
5 3/16" @ 3298'

(Figures Indicate Bottom of Formations)

<u>FORMATIONS:</u>	<u>DEPTH</u>	<u>FORMATION TOPS</u>	
Sand	70	Anhydrite	520 /1259
Clay	125	Topeka	2675 -896
Clay & Sand	170	Lansing	3070 -1291
Red Bed	520	Arbuckle	3297 -1518
Anhydrite	545	Set 5" @	3298 -1519
Red Bed	600	Total Depth	3308 1/2 -1529 1/2
Shale and Shells	1195		
Shale & Salt	1260		
Broken Lime & Shale	1439		
Broken Lime	1673		
Lime	1855		
Shale & Shells	1900		
Broken Lime	2210		
Shale & Shells	2435		
Broken Lime	2498		
Shale & Shells	2606		
Shale & Lime	2693		
Lime	2815		
Broken Lime	2882		
Lime	2940		
Shale & Broken Lime	2953		
Shale & Lime Shells	3063		
Shale	3065		
Broken Lime	3098		
Lime	3157		
Lime & Shale Breaks	3255		
Broken Lime	3300		
Lime	3308 1/2 TD		

I hereby certify that the above is a true and correct copy of Driller's Log of well drilled in the S/2 SE NW of Section 8, Township 20 South, Range 11 West, Barton County, Kansas.

ALPINE OIL & ROYALTY CO., INC.

By: *Walter J. Ford*Subscribed and sworn to before me this 8th day of February 1950

RECEIVED

My commission expires
August 8, 1953*Lawrence Allen*
Notary Public

FEB 8 X 1950

STATE CORPORATION
COMMISSION
KANSAS