

WELL PLUGGING RECORD

STATE OF KANSAS
STATE CORPORATION COMMISSION

Give All Information Completely
Make Required Affidavit
Mail or Deliver Report to:
Conservation Division
State Corporation Commission
800 Bitting Building
Wichita, Kansas

FORMATION PLUGGING RECORD

OR

Barton County. Sec. 15 Twp. 20 Rge. 11 (E) 11 (W)

Location as "NE $\frac{1}{4}$ NW $\frac{1}{4}$ SW $\frac{1}{4}$ " or footage from lines SW SW NW

Lease Owner Robert L. Williams

Lease Name Jutting Well No. 1

Office Address Union National Bank Bldg.; Wichita, Kansas

Character of Well (completed as Oil, Gas or Dry Hole) Dry

Date well completed 3/26 1949

Application for plugging filed 3/26 1949


Application for plugging approved 3/27 1949

Plugging commenced 3/27 1949

Plugging completed 3/27 1949

Reason for abandonment of well or producing formation Dry

NORTH

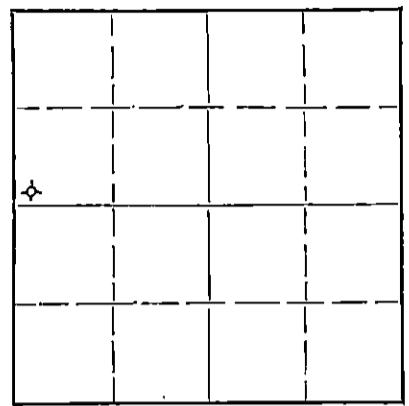

Locate well correctly on above Section Flat

If a producing well is abandoned, date of last production _____ 19____

Was permission obtained from the Conservation Division or its agents before plugging was commenced? Yes

Name of Conservation Agent who supervised plugging of this well G. D. Stough

Producing formation _____ Depth to top _____ Bottom _____ Total Depth of Well 3400 Feet

Show depth and thickness of all water, oil and gas formations.

OIL, GAS OR WATER RECORDS CASING RECORD

Formation	Content	From	To	Size	Put In	Pulled Out
				8-5/8"	240'	

Describe in detail the manner in which the well was plugged, indicating where the mud fluid was placed and the method or methods used in introducing it into the hole. If cement or other plugs were used, state the character of same and depth placed, from _____ feet to _____ feet for each plug set.

Filled hole with heavy mud to 230'. Set wooden plug @ 230'.

Mixed and pumped thru drill pipe on top of plug 15 sax cement.

Filled hole with heavy mud to 25'. Set wooden plug @ 25'

Mixed and dumped 10 sax cement on plug.

RECORDED
Conservation
APR 6 1949
STATE CORPORATION COMMISSION
KANSAS

4-6-49

(If additional description is necessary, use BACK of this sheet)

Correspondence regarding this well should be addressed to Robert L. Williams
Address Union National Bank Building; Wichita, Kansas

STATE OF Kansas, COUNTY OF Sedgwick, ss.
Wm. S. Brunson (employee of owner) or (owner or operator) of the above-described well,

being first duly sworn on oath, says: That I have knowledge of the facts, statements, and matters herein contained and the log of the above-described well as filed and that the same are true and correct. So help me God. Brunson Drilling Co., Inc.

(Signature) BY William S. Brunson
302-304 Central Building; Wichita, Kansas
(Address)

SUBSCRIBED AND SWORN to before me this 29th day of March, 1949

My commission expires September 10, 1951

John C. Detweiler
Notary Public.

PLUGGING
FILE SEC 15 T 20 R 11 W
BOOK PAGE 88 LINE 37

ROBERT L. WILLIAMS

Well: Jutting #1
SW SW NW Sec. 15-205-11W
Commenced RD: 3/15/49
Completed RD: 3/26/49
Total Depth : 3400'
Casing : 240' 8 1/2"

Barton County, Kansas
Elevation :
Initial Prod: Dry
Contractor : Brunson Drilling Co., Inc.

STRATA	DEPTH
Sand	85
Clay & shells	130
Shale & shells	160
Sand, shale & shells	200
Shale & shells	240
Redbed	505
Anhydrite	530
Shale & shells	740
Shale	885
Shale & shells	960
Salt & shells	1140
Shale & shells	1200
Shale & lime	1735
Lime	1950
Shale & lime	2665
Lime	2990
Shale & lime	3152
Lime	3325
Dolerite	3360
Lime	3400
Total Depth	3400

Tops:
 Topoka - 2580'
 Neekma - 2926'
 Brown Line - 3051'
 Lansing - 3070'
 Arbuckle - 3323'
 D & F

I hereby certify that the above is a true and correct log of said well as reflected by the daily drilling reports.

REC'D

BRUNSON DRILLING COMPANY, Inc.
By

APR - 6 1949
STATE CORPORATION
COMMISSION
KANSAS

William S. Brunson
Wm. S. Brunson Sec.

Signed and sworn to in my presence this 29th day of March, 1949, by Wm. S. Brunson, secretary of the Brunson Drilling Company, Inc., a corporation in the State of Kansas.

Jan E. Retzler
Notary Public

My commission expires September 10, 1951.

PLUGGING
FILE SEC 15 T 20 R 11W
BOOK PAGE 88 LINE 37