


STATE OF KANSAS
STATE CORPORATION COMMISSION

WELL PLUGGING RECORD

Give All Information Completely
Make Required Affidavit
Mail or Deliver Report to:
Conservation Division
State Corporation Commission
800 Bitting Building
Wichita, Kansas

McPherson County. Sec. 6 Twp. 19 Rge. (E) 1(W)

Location as "NE/CNW&SW" or footage from lines SW SW SE
Lease Owner Barbara Oil Company
Lease Name Smith Well No. 1
Office Address 322 Central Building, Wichita 2, Kansas
Character of Well (completed as Oil, Gas or Dry Hole) Oil
Date well completed November 10, 19 44
Application for plugging filed December 19, 19 55
Application for plugging approved December 20, 19 55
Plugging commenced January 3, 19 56
Plugging completed January 12, 19 56
Reason for abandonment of well or producing formation Depleted

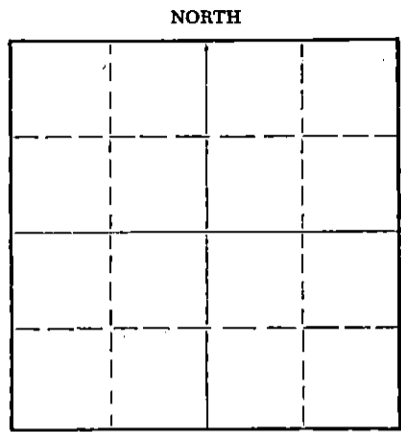

Locate well correctly on above Section Plat

If a producing well is abandoned, date of last production December 15, 19 55
Was permission obtained from the Conservation Division or its agents before plugging was commenced? Yes

Name of Conservation Agent who supervised plugging of this well Ruel Durkee
Producing formation Mississippi Depth to top 2944 Bottom Total Depth of Well 2979 Feet
Show depth and thickness of all water, oil and gas formations.

OIL, GAS OR WATER RECORDS

CASING RECORD

FORMATION	CONTENT	FROM	TO	SIZE	PUT IN	PULLED OUT
				8 1/4"	160'	None
				5 1/2"	2965'	2263'

Describe in detail the manner in which the well was plugged, indicating where the mud fluid was placed and the method or methods used in introducing it into the hole. If cement or other plugs were used, state the character of same and depth placed, from feet to feet for each plug set.

Filled hole with sand from 2979 to 2950, six sacks cement, filled with mud up to 155', dumped 15 sacks cement, filled with mud to within 6' of top, then 5 sacks cement on top.

1-14-56

CONS. DIVISION
Wichita, Kansas

(If additional description is necessary, use BACK of this sheet)

Name of Plugging Contractor Barbara Oil Company Tools
Address 322 Central Building, Wichita 2, Kansas

STATE OF Kansas, COUNTY OF Sedgwick, ss.
L.W. Davidson (employee of owner) or (owner or operator) of the above-described well, being first duly sworn on oath, says: That I have knowledge of the facts, statements, and matters herein contained and the log of the above-described well as filed and that the same are true and correct. So help me God.

(Signature) L.W. Davidson
322 Central Building, Wichita 2, Kansas
(Address)

SUBSCRIBED AND SWORN to before me this 13th day of January, 19 56

Mildred Fisher
Notary Public.

My commission expires March 2, 1957

PLUGGING
FILE SEC-6 T-19 R-1W
BOOK PAGE 25 LINE 10

BARBARA OIL COMPANY

Margaret Smith Atal Well No. 1 SW SW SE Section 6-19S-1W
McPherson County, Kansas

Drilled by Beardmore Drilling Co
Drilling commenced October 18, 1944
Drilling completed November 10, 1944
Well drilled with rotary tools

Casing record
8 1/2" 24# 160'
5 1/2" 14# 2965' -

Formation	From	To
Soil & clay	0	25
Sand	25	50
Shale & shells	50	375
Shale & lime	375	560
Lime	560	655
Lime broken	655	790
Shale & lime	790	1485
Lime broken	1485	1575
Shale & lime	1575	1810
Lime broken	1810	1915
Shale & lime	1915	1955
Lime	1955	2000
Lime broken	2000	2260
Lime	2260	2400
Lime broken	2400	2690
Lime	2690	2860
Shale	2860	2910
Shale & lime	2910	2950
Chert & chert	2950	2960
Chat	2960	2968
Chat & lime	2968	2979 T.D.

Top Mississippi Line 2944
Top Chert 2957
Dolomite 2970 2979
Producing 2970 2979

PLUGGING
WELL SEC 6 T 19 S 1 W
BOOK PAGE 25 LINE 10

STATE OF KANSAS)
) SS
COUNTY OF SEDGWICK)

I, the undersigned, being duly sworn on oath, state that the above and within statement is a true and correct record and log of the well drilled on the location above described, to the best of my knowledge and belief.

Dee Davidson

Subscribed and sworn to before me this 19th day of December 1955

RECEIVED
STATE COMMISSION

JAN 9 - *W. H. Fisher*
Notary Public

My Commission Expires:
March 2, 1957

DECEMBER 20 1955
CONSERVATION DIVISION
Wichita, Kansas

PLUGGING
WELL SEC 6 T 19 S 1 W
BOOK PAGE 25 LINE 10