


15-009-050260000

STATE OF KANSAS
STATE CORPORATION COMMISSION
Give All Information Completely
Make Required Affidavit
Mail or Deliver Report to:
Conservation Division
State Corporation Commission
800 Biting Building
Wichita, Kansas

WELL PLUGGING RECORD

Barton County, Sec. 7 Twp. 16S Rge. (E) 13 (W)
Location as "NE/CNW $\frac{1}{4}$ SW $\frac{1}{4}$ " or footage from lines SW NE SE
Lease Owner Peel-Hardman Producers
Lease Name McClanahan Well No. 1
Office Address P. O. Box 359, Hoisington, Kansas
Character of Well (completed as Oil, Gas or Dry Hole) Dry Hole
Date well completed July 9, 1949
Application for plugging filed July 9, 1949
Application for plugging approved July 9, 1949
Plugging commenced July 12, 1949
Plugging completed July 12, 1949
Reason for abandonment of well or producing formation Dry Hole

NORTH

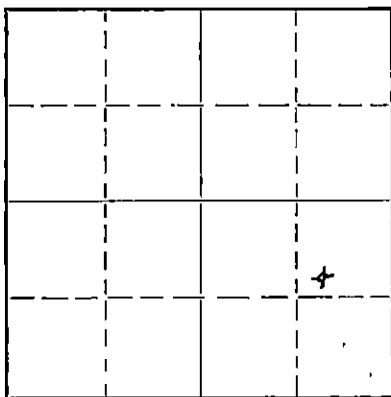

Locate well correctly on above Section Plat

If a producing well is abandoned, date of last production _____ 19____
Was permission obtained from the Conservation Division or its agents before plugging was commenced? Yes

Name of Conservation Agent who supervised plugging of this well C. D. Stough
Producing formation _____ Depth to top _____ Bottom _____ Total Depth of Well 3365 Feet
Show depth and thickness of all water, oil and gas formations.

OIL, GAS OR WATER RECORDS

CASING RECORD

Formation	Content	From	To	Size	Put In	Pulled Out
		0	627'	8 5/8"	627'	None
		0	3362'	5 1/2"	3362'	2700'

Describe in detail the manner in which the well was plugged, indicating where the mud fluid was placed and the method or methods used in introducing it into the hole. If cement or other plugs were used, state the character of same and depth placed, from _____ feet to _____ feet for each plug set.

3365' - 3111 $\frac{1}{2}$ ' - Heavy Rotary Mud
 3111 $\frac{1}{2}$ ' - 3110' - Rock Bridge
 3110' - 3070' - 5 sacks cement
 3070' - 251 $\frac{1}{2}$ ' - Heavy Rotary Mud
 251 $\frac{1}{2}$ ' - 250' - Rock Bridge
 250' - 203' - 15 sacks cement
 203' - 23 $\frac{1}{2}$ ' - Heavy Rotary Mud
 23 $\frac{1}{2}$ ' - 22' - Rock Bridge
 22' - 6' - 5 sacks cement
 6' - Surface - Celler

RECORDED
AUG 1 1949
8-1-49
CONSERVATION DIVISION

(If additional description is necessary, use BACK of this sheet)
Correspondence regarding this well should be addressed to Peel-Hardman Producers
Address P. O. Box 359
Hoisington, Kansas

STATE OF Kansas, COUNTY OF Barton, SS.
J. B. Andrews (employee of owner) or (owner) of the above-described well,
being first duly sworn on oath, says: That I have knowledge of the facts, statements, and matters herein contained and the log of the above-described well as filed and that the same are true and correct. So help me God.

(Signature) J. B. Andrews
P. O. Box 359, Hoisington, Kansas
(Address)

SUBSCRIBED AND SWORN to before me this 29th day of July, 1949.
Marion M. Herber
Notary Public.

My commission expires June 4, 1951

PLUGGING
FILE SEC 7 T 16 R 13W
BOOK PAGE 109 LINE 24

DRILLER'S LOG

Company: Peel-Hardman Producers

Sec. 7 Twp. 16S Rge. 13W
SW NE SE

Farm: McClanahan Well No. 1

County: Barton,
Kansas

Total Depth: 3365' (Rotary)

Comm.: 6-3-49 Comp. 6-15-49

Contractor: Glenn Peel Drilling Co., Inc.

Elevation:

Casing:

8 5/8" 627' cem.
5 1/2" 3362' cem.

Production:

Figures below indicate bottom of formations

Surface Clay, Shale and Shells	0 -	135
Shale and Shells		420
Sand and Shale Streaks		550
Shale		628
Shale and Rock		890
Anhydrite		920
Shale and Shells		1080
Shells		1385
Shale and Lime		1855
Lime		1955
Iron		1960
Lime and Shale		2245
Shale and Lime		2300
Shale		2370
Shale and Lime		2515
Shale		2700
Shale and Lime		2825
Lime		3365
Total Depth (Rotary)		3365

Total Depth (Rotary) - 3363' D.F.
Top Arbuckle - 3359' D.F.

This is to certify that the above information is, to the best of our knowledge, true and correct.

GLENN PEEL DRILLING COMPANY, INC.

BY: [Signature]

SUBSCRIBED AND SWORN to before me this 21st day of June, 1949

My commission expires June 4, 1951

[Signature]
Notary Public

RECEIVED
Conservation Div.
JUN 22 1949
STATE CORPORATION
COMMISSION
KANSAS

PLUGGING
FILE SEC 7 T 16 R 134
BOOK PAGE 105 LINE 24