


Give All Information Completely  
Make Required Affidavit  
Mail or Deliver Report to:  
Conservation Division  
State Corporation Commission  
211 No. Broadway  
Wichita, Kansas

15-009-16178-000

WELL PLUGGING RECORD

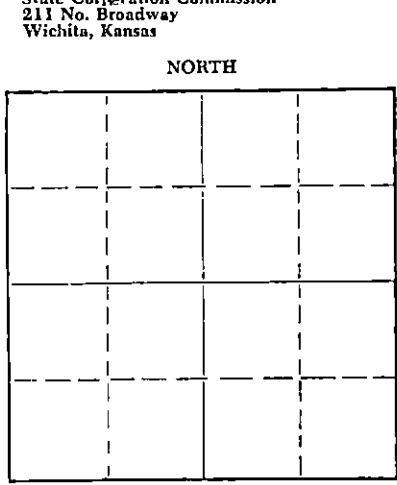

Locate well correctly on above Section Plat

Barton County. Sec. 7 Twp. 16 Rge. (E) 13(W)  
Location as "NE/CNW/SW" or footage from lines NW NW SW  
Lease Owner W. A. Barton Pipe & Supply  
Lease Name Hoffman Well No. 5  
Office Address Route # 4, Shawnee Okla.  
Character of Well (completed as Oil, Gas or Dry Hole) Oil  
Date well completed \_\_\_\_\_ 19\_\_\_\_  
Application for plugging filed July 7 19 62  
Application for plugging approved \_\_\_\_\_ 19\_\_\_\_  
Plugging commenced July 10 19 62  
Plugging completed July 13 19 62  
Reason for abandonment of well or producing formation \_\_\_\_\_

If a producing well is abandoned, date of last production \_\_\_\_\_ 19\_\_\_\_  
Was permission obtained from the Conservation Division or its agents before plugging was commenced? yes

Name of Conservation Agent who supervised plugging of this well Donald Truan  
Producing formation \_\_\_\_\_ Depth to top \_\_\_\_\_ Bottom \_\_\_\_\_ Total Depth of Well 3362 Feet  
Show depth and thickness of all water, oil and gas formations.

OIL, GAS OR WATER RECORDS				CASING RECORD		
FORMATION	CONTENT	FRDM	TD	SIZE	PUT IN	PULLED OUT
				10 3/4"	644'	none
				7"	3340'	2248'

Describe in detail the manner in which the well was plugged, indicating where the mud fluid was placed and the method or methods used in introducing it into the hole. If cement or other plugs were used, state the character of same and depth placed, from \_\_\_\_\_ feet to \_\_\_\_\_ feet for each plug set.

Sanded hole to 3330'-dumped 5 sks cement-pulled casing-mudded hole to 350'-set 10' rock bridge-dumped 30 sks cement-mudded hole to 35'-set 10' rock bridge-dumped 15 sks cement to base of cellar.

RECEIVED  
STATE CORPORATION COMMISSION

8-2-62 AUG 1962

CONSERVATION DIVISION  
Wichita, Kansas

(If additional description is necessary, use BACK of this sheet)  
Name of Plugging Contractor R & D Casing Pulling Co. License # 236  
Address Box 572, Hutchinson, Kansas

STATE OF Oklahoma, COUNTY OF Pottawatomie, ss. \_\_\_\_\_ (employee of owner) or (owner or operator) of the above-described well, being first duly sworn on oath, says: That I have knowledge of the facts, statements, and matters herein contained and the log of the above-described well as filed and that the same are true and correct. So help me God.

(Signature) W. A. Barton Pipe & Supply  
W. A. Barton  
154 Shawnee Okla

SUBSCRIBED AND SWORN TO before me this 1st day of August, 19 62

My commission expires January 16, 1965  
Russell Nathaniel Notary Public.

SMELL PETROLEUM CORP.  
 Hoffman No. 6-A.

7 16 13W  
 SEC. 7 T. 15 R. 13W.  
 NW 1/4 SW  
 330' NL 330' W.L. S7 1/2

15-009-16178-00-00

County, Barton.



Elevation.

Production. Pot. 2719 B.

Total Depth, 3332  
 Com. 7-22-32 Comp. 6-19-38  
 Shot or Treated, 3000 gal acid.  
 Contractor, Crow Drilling Co.  
 Issued, 9-17-33

CASINGS.

10 3/4" 644 7" 3340'

Figures Indicate Bottom of Formations.

sand and shale strks	150
shale and shells	325
shale and lime	580
shale red	600
red rock	645
shale and shells	875
anhydrite	902
shale and shells	1232
salt and shale	1304
shale and salt streaks	1556
broken lime	1627
lime	1645
shale and lime	1934
lime	1948
shale	1952
shale and lime	2112
shale and lime strks	2308
shale and lime	2406
shale and lime strks	2524
shale and lime	2665
shale and lime strks	2778
shale	2793
lime	3026
lime and shale	3191
lime	3336
dolomite	3332
Total Depth,	

Core No. 4	3352-57
	Fair oil stain.
Core No. 5	3356-60
	Spotted light stain.
Core No. 6	3358-60
	light oil stain.
Core No. 7	3360-62
	Light oil stain

Oil stain 2974-83  
 good oil stain 3126-44

Core No. 1 3339-42  
 no porosity or oil stain.

Core No. 2 3342-47  
 bleeding small amt of oil.

Core No. 3 3347-52  
 Trac. of oil stain.