


STATE OF KANSAS
STATE CORPORATION COMMISSION

Give All Information Completely
Make Required Affidavit
Mail or Deliver Report to:
Conservation Division
State Corporation Commission
211 No. Broadway
Wichita, Kansas

WELL PLUGGING RECORD

15.009.14278.0000

NORTH

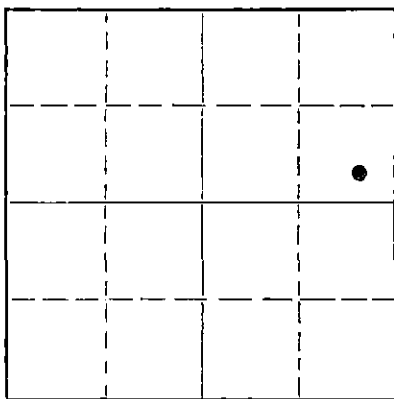

Locate well correctly on above
Section Plat

Barton County. Sec. 2 Twp. 20 Rge. 11 (~~EXX~~) (W)
Location as "NE/CNW/SW" or footage from lines SE SE NE
Lease Owner Pan American Petroleum Corporation
Lease Name F. Panning "B" Well No. 11
Office Address Oklahoma City, Oklahoma
Character of Well (completed as Oil, Gas or Dry Hole) Oil
Date well completed 5-14- 19 38
Application for plugging filed 2-26- 19 57
Application for plugging approved 2-27- 19 57
Plugging commenced 3-21- 19 57
Plugging completed 3-28- 19 57
Reason for abandonment of well or producing formation Economically Depleted

If a producing well is abandoned, date of last production 10-16- 19 56
Was permission obtained from the Conservation Division or its agents before plugging was commenced? Yes

Name of Conservation Agent who supervised plugging of this well R. M. Brundage
Producing formation Arbuckle Depth to top 3272 Bottom 3281 Total Depth of Well 3281 Feet
Show depth and thickness of all water, oil and gas formations.

OIL, GAS OR WATER RECORDS

CASING RECORD

FORMATION	CONTENT	FROM	TO	SIZE	PUT IN	PULLED OUT
Arbuckle	Oil-Depleted	3272	3281	10-3/4 6	208 3293	None 1478

Describe in detail the manner in which the well was plugged, indicating where the mud fluid was placed and the method or methods used in introducing it into the hole. If cement or other plugs were used, state the character of same and depth placed, from _____ feet to _____ feet for each plug set.

Sand 3281-3260
6 Sx Cement 3260-3225
Hvy Mud 3225- 200
Crushed Rock 200- 190
25 Sx Cement 190- 140
Hvy Mud 140- 20
Crushed Rock 20- 15
10 Sx Cement 15- To base of Cellar

(If additional description is necessary, use BACK of this sheet)

Name of Plugging Contractor R & D Casing Pulling Company
Address Ellinwood, Kansas

STATE OF KANSAS, COUNTY OF BARTON, ss.
I, G. A. Reynolds

(employee of owner) or (~~owner~~) of the above-described well, being first duly sworn on oath, says: That I have knowledge of the facts, statements, and matters herein contained and the log of the above-described well as filed and that the same are true and correct. So help me God.

(Signature) G. A. Reynolds

Box 7, Ellinwood, Kansas
(Address)

SUBSCRIBED AND SWORN to before me this 2nd day of April, 19 57

My commission expires November 12, 1958

Notary Public.

PLUGGING
FILE SEC 2 T 20 R 11 W
BOOK PAGE 144 LINE 3

RECEIVED
STATE CORPORATION COMMISSION

APR 3 - 1957 4-3-57

CONSERVATION DIVISION
Wichita, Kansas

640 Acres

N

R 11 W

STANOLIND OIL AND GAS COMPANY

WELL RECORD

	160				160	
	160				160	

Locate Well Correctly

COUNTY Darton, SEC. 2, TWP. 20, RGE. 11 W
COMPANY OPERATING Stanolind Oil and Gas co
OFFICE ADDRESS Box 591, Tulsa, Oklahoma
FARM NAME Fred Fanning "B" WELL NO. 11
DRILLING STARTED Apr. 15, 38, DRILLING FINISHED 19
WELL LOCATED S2 $\frac{1}{4}$ S2 $\frac{1}{4}$ NE $\frac{1}{4}$ 330 ft. North of South
Line and 2310 ft. East of West Line of Quarter Section.
ELEVATION (Relative to sea level) DERRICK FLR. 1765 GROUND 1763
CHARACTER OF WELL (Oil, gas or dry hole) Oil

OIL OR GAS SANDS OR ZONES

Name	From	To	Name	From	To
1 <u>Siliceous Lims</u>	<u>3272</u>	<u>3281</u>	4		
2			5		
3			6		

WATER SANDS

Name	From	To	Water Level	Name	From	To	Water Level
1				4			
2				5			
3				6			

CASING RECORD

Size	Wt.	Thds.	Make	Amount Set		Amount Pulled		Packer Record			
				Ft.	In.	Ft.	In.	Size	Length	Depth Set	Make
<u>10-3/4</u>	<u>CD 35.73</u>	<u>8</u>	<u>Beth'lm</u>	<u>203</u>	<u>5</u>			<u>(Threads off - landed at 203'-5")</u>			
<u>8</u>	<u>CD 20</u>	<u>10</u>	<u>Met'l</u>	<u>3264</u>	<u>5</u>			<u>(Threads off - landed at 3272')</u>			

Liner Record: Amount _____ Kind _____ Top _____ Bottom _____

CEMENTING AND MUDDING RECORD

Size	Amount Set		Sacks Cement	Chemical		Method Cementing	Amount	Mudding Method	Results (See Note)
	Feet	In.		Gal.	Make				
<u>10-3/4</u>	<u>203</u>	<u>8</u>	<u>200</u>		<u>Incor</u>	<u>Halliburton</u>			
<u>6"</u>	<u>CD 3275</u>	<u>2</u>	<u>100</u>		<u>Incor</u>	<u>Halliburton</u>			

NOTE: What method was used to protect sands when outer strings were pulled? _____

NOTE: Were bottom hole plugs used? _____ If so, state kind, depth set and results obtained. _____

PLUGGING

FILE SEC 2 T 20 R 11W
BOOK PAGE 144 LINE 3

TOOLS USED

Rotary tools were used from 0 feet to 3276 feet, and from _____ feet to _____ feet.
Cable tools were used from 3276 feet to 3281 feet, and from _____ feet to _____ feet.
Type Rig 54' Steel

100 bbl per hour. Swab 1000' off bottom. May 15, 1938 after acidizing

Production first 24 hours _____ bbls. Gravity _____ Emulsion _____ per cent., Water _____ per cent.
Initial potential 2000 bbl oil no water. 38-54 bbl 5" 203 6" casing
Production second 24 hours _____ bbls. Gravity _____ Emulsion _____ per cent., Water _____ per cent.

If gas well, cubic feet per 24 hours _____ Rock Pressure, lbs. per square inch. _____

I, the undersigned, being first duly sworn upon oath, state that this well record is true, correct and complete according to the records of this office and to the best of my knowledge and belief.

Name and Title

Subscribed and sworn to before me this the _____ day of _____, 193_____

My commission expires _____

Notary Public,

FORMATION RECORD

Give detailed description and thickness of all formations drilled through and contents, of sand, whether dry, water, oil or gas.

Formation	Top	Bottom	Formation	Top	Bottom
Surface Clay	0	15	Swab 100 bbls per hr-10000 off bottom		
Sand	15	85			
Shale and lime shells	85	215	Total Depth	3281	
Red rock	215	334			
Red rock and shale	234	470	Date First work Apr 9, 1938		
Anhydrite	470	495			
Shale	495	497	Date drilling completed May 8, 1938		
Red rock	497	750	Date well completed May 14, 1938		
Shale, blue	750	900	Date potential effective May 14, 1938		
Broken lime	900	920			
Salt and shale	920	1245			
Shale	1245	1285			
Lime	1285	1320			
Broken Lime	1320	1610			
Sand	1610	1630			
Lime	1630	1640			
Sand	1640	1675			
Lime	1675	1685			
Broken lime	1685	2075			
Shale	2075	2090			
Broken lime	2090	2120			
Shale	2120	2270			
Broken lime	2270	2309			
Shale	2309	2355			
Broken lime	2355	2460			
Shale	2460	2490			
Broken lime	2490	2550			
Shale	2550	2610			
Lime	2610	2645			
Broken lime	2645	2670			
Shale	2670	2987			
Lime	2987	3090			
Lime porous	3090	3108			
Lime	3108	3150			
Broken lime	3150	3155			
Lime	3155	3190			
Broken lime	3190	3200			
Lime	3200	3241			
Lime, Broken	3241	3263			
Core #1 5 1/2 Rec					
Lime, gray	3263	3267			
Shale, blue	3267	3270 1/2			
Made while running	3270 1/2	3271			
Core #2 3 1/2 Rec					
Lime, tan to gray with thin gray shale streaks	3271	3272			
Dolomite, tan, w/ to cr with cherty streaks, good por. fair sat.	3272	3276			
Top Siliceous	3272				
Cable Tools					
Made while drilling cement	3276	3277			
Core #1 1 1/2 Rec					
Lime, gray, hard with small increase in oil	3277	3279			
Core #2 2 1/2 Rec					
Lime small increase in oil (oil 2300' off bottom)	3279	3281			
Swab-6 bbls per hr.					
Acidizing Record					
2000 gallons Dowell xx May 9, 1938					
3000 gallons Dowell xx May 11, 1938					
3000 gallons Dowell xx May 12, 1938					