

WELL PLUGGING RECORD

Give All Information Completely
Make Required Affidavit
Mail or Deliver Report to:
Conservation Division
State Corporation Commission
800 Bitting Building
Wichita, Kansas

Barton County, Sec. 2 Twp. 20S Rge. 11 (E) W (W)

Location as "NE/CNW $\frac{1}{4}$ SW $\frac{1}{4}$ " or footage from lines SE/4, NE/4, NE/4

Lease Owner Stanford Oil and Gas Company

Lease Name Fred Panning "B" Well No. 13

Office Address P. O. Box 1654, Oklahoma City, Oklahoma

Character of Well (completed as Oil, Gas or Dry Hole) Oil

Date well completed 8-1 1938

Application for plugging filed 12-31 1951

Application for plugging approved 1-2 1952

Plugging commenced 1-26 1952

Plugging completed 1-30 1952

Reason for abandonment of well or producing formation depleted

If a producing well is abandoned, date of last production 11-14 1951

Was permission obtained from the Conservation Division or its agents before plugging was commenced? yes

Name of Conservation Agent who supervised plugging of this well C. D. Stough

Producing formation Arbuckle Depth to top 3273 Bottom 3284 Total Depth of Well 3284 Feet

Show depth and thickness of all water, oil and gas formations.

OIL, GAS OR WATER RECORDS

CASING RECORD

Formation	Content	From	To	Size	Put In	Pulled Out
<u>Arbuckle or</u>	<u>Oil</u>	<u>3273</u>	<u>3284</u>	<u>10-3/4</u>	<u>198</u>	<u>None</u>
<u>Siliceous Lime</u>	<u>depleted</u>			<u>6</u>	<u>3268</u>	<u>2768</u>

Describe in detail the manner in which the well was plugged, indicating where the mud fluid was placed and the method or methods used in introducing it into the hole. If cement or other plugs were used, state the character of same and depth placed, from _____ feet to _____ feet for each plug set.

Rock Bridge 3284 - 3260
5 sx cement 3260 - 3230
hvy. mud 3230 - 214
Rock Bridge 214 - 204
20 sx cement 204 - 144
hvy. mud 144 - 30
10 sx cement 30 - bottom of cellar

(If additional description is necessary, use BACK of this sheet)

Name of Plugging Contractor West Supply Company
 Address Chase, Kansas

STATE OF Kansas, COUNTY OF Barton, ss.

G. A. Younie (employee of owner) or (owner or operator) of the above-described well, being first duly sworn on oath, says: That I have knowledge of the facts, statements, and matters herein contained and the log of the above-described well as filed and that the same are true and correct. So help me God.

(Signature) G. A. Younie
Box 7, Ellinwood, Kansas
 (Address)

SUBSCRIBED AND SWORN TO before me this 1st day of February, 19 52.

My commission expires May 2, 1955

Leus L. Donovan
 Notary Public.

FEB 2 X 1952 2-2-52

FILE 2 20
 BOX 34 1952

CONSERVATION DIVISION
 Wichita, Kansas

15.009.14298.0000

Sand and Shale	0	210
Red Rock	210	485
Andydrite	485	505
Shale and Shells	505	1025
Salt	1025	1230
Shale and Shells	1230	1425
Lime and Shale	1425	1592
Shale and Shells	1592	1865
Lime and Shale	1865	1975
Shale and Shells	1975	2140
Broken Shale	2140	2290
Broken Lime	2290	2406
Shale and Shells	2406	2521
Broken Lime	2521	2600
Shale	2600	2645
Lime	2645	2850
Broken Lime	2850	2891
Shale and Lime	2891	2985
Lime	2985	2067
Lime and Shale	3067	3230
Lime	3230	3268

<u>Core #1</u> 6' 1/8' Rec.	3268	3276
Shale, green, crumbly		
Limestone, gray, pyritic		
w/gray shale partings	3270	3273
Dolomite, tan crystalline		
w/fair por. & pair sat.	3273	3276

Top Siliceous 3273

<u>Cable Tools</u>		
Made while cleaning out	3276	3278

<u>Core #1</u> 0' 1/4' Rec.	3278	3282
Dolomite, good increase		

<u>Core #2</u> 1' 1/2' Rec.	3282	3284
Hard dolomite, fair por.		

Swabbed 25 bbl/hr. 2-hr. Test

Acidized w/2000 gal. Dowell XX July 30, 1938

Swabbed 64 bbl/hr, 2-hr. Test

Total Depth 3284


Date of first work	7-5-38
Date Spudded	7-14-38
Date Drilling Completed	7-29-38
Date Well Completed	8-1-38
Date Potential Effective	8-4-38

15.009.14298.0000
 2120-R(W)
 134 LINE 26
 1938

640 Acres
R 11 W

STANOLIND OIL AND GAS COMPANY
WELL RECORD

15-1-30
2011

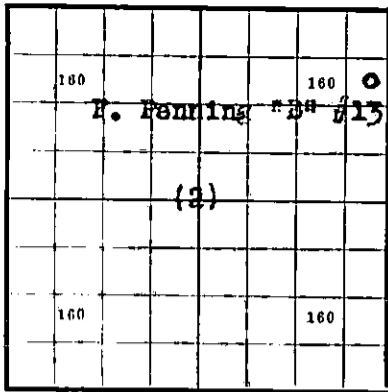

COUNTY Barton, SEC. 2, TWP. 20 S, RGE. 11 W
 COMPANY OPERATING Stanolind Oil and Gas Company
 OFFICE ADDRESS Box 591, Tulsa, Oklahoma
 FARM NAME F. Panning #B# WELL NO. 13
 DRILLING STARTED July 14 1938, DRILLING FINISHED July 29 1938
 WELL LOCATED SE 1/4 NE 1/4 NE 1/4 1650 ft. North of South
 Line and 2310 ft. East of West Line of Quarter Section.
 ELEVATION (Relative to sea level) DERRICK FLR. 1765 GROUND 1762
 CHARACTER OF WELL (Oil, gas or dry hole) Oil

OIL OR GAS SANDS OR ZONES

Name	From	To	Name	From	To
1 Siliceous Line	3273'				
2					
3					

WATER SANDS

Name	From	To	Water Level	Name	From	To	Water Level
1				4			
2				5			
3				6			

CASING RECORD

Size	Wt.	Thds.	Make	Amount Set		Amount Pulled		Packer Record			
				Ft.	In.	Ft.	In.	Size	Length	Depth Set	Make
10 1/2" OD	35.75#	8	Wat'l.	198	1	(Threads off - Landed 204')					
6" OD	20#	10	"	3268	3	(Threads off - Landed 3273')					

Liner Record: Amount _____ Kind _____ Top _____ Bottom _____

CEMENTING AND MUDDING RECORD

Size	Amount Set		Sacks Cement	Chemical		Method Cementing	Amount	Mudding Method	Results (See Note)
	Feet	In.		Gal.	Make				
10 1/2" OD	200	7	225	Incor		Halliburton			
6" OD	3295		100	"		"			

NOTE: What method was used to protect sands when outer strings were pulled? _____

NOTE: Were bottom hole plugs used? _____ If so, state kind, depth set and results obtained _____

TOOLS USED

Rotary tools were used from 0 feet to 3276 feet, and from _____ feet to _____ feet.
 Cable tools were used from 3276 feet to 3284 feet, and from _____ feet to _____ feet.
 Type Rig _____

PRODUCTION DATA

Swabbed 25 bbl./hr. on 2-hr. test before acid
 Production first 24 hours _____ bbls. Gravity _____ Emulsion _____ per cent., Water _____ per cent.
 Initial potential made 1385 bbl. oil pumping 35-54" S.P.M. thru 3" BUE tubing.
 Production second 24 hours _____ bbls. Gravity _____ Emulsion _____ per cent., Water _____ per cent.

If gas well, cubic feet per 24 hours _____ Rock Pressure, lbs. per square inch _____

I, the undersigned, being first duly sworn upon oath, state that this well record is true, correct and complete according to the records of this office and to the best of my knowledge and belief.

H. E. Pilling
Name and Title

Subscribed and sworn to before me this the 11th day of August, 1938

My commission expires May 3, 1941
Stanley D. Wilson
Notary Public.