

15.159.04492.0000

WELL PLUGGING RECORD

STATE OF KANSAS  
STATE CORPORATION COMMISSION

Give All Information Completely  
Make Required Affidavit  
Mail or Deliver Report to:  
Conservation Division  
State Corporation Commission  
800 Bittig Building  
Wichita, Kansas

OR  
~~FORMATION RECORD~~ Strike out upper line when reporting plugging of formations.

Rice County. Sec. 21 Twp. 20S Rge. (E) 10 (W)

Location as "NE $\frac{1}{4}$ NW $\frac{1}{4}$ SW $\frac{1}{4}$ " or footage from lines. E/2 NW/4, 990' fm Nth & 330' fm East

Lease Owner Sinclair Prairie Oil Co

Lease Name Lewis A. Thompson Well No. 7

Office Address Box 521, Tulsa, Okla.

Character of Well (completed as Oil, Gas or Dry Hole) Oilwell

Date, well completed May 7 19 35

Application for plugging filed June 24 19 41

Application for plugging approved June 25 19 41


Plugging Commenced July 13 19 41

Plugging Completed July 19 19 41

Reason for abandonment of well or producing formation dry

If a producing well is abandoned, date of last production June 5 19 41

Was permission obtained from the Conservation Division or its agents before plugging was commenced? Yes

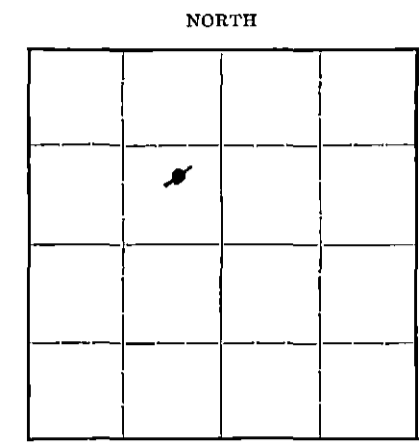

Locate well correctly on above Section Plat

Name of Conservation Agent who supervised plugging of this well Ruel Durkee  
Producing formation Kas City Depth to top 3045 Bottom Total Depth of Well 3140 Feet

Show depth and thickness of all water, oil and gas formations.

OIL, GAS OR WATER RECORDS

CASING RECORD

Formation	Content	From	To	Size	Put In	Pulled Out
Kans City	dry	3045	3140	13"OD	131'	0'
				5-1/2 OD	3171'	981'

Describe in detail the manner in which the well was plugged, indicating where the mud fluid was placed and the method or methods used in introducing it into the hole. If cement or other plugs were used, state the character of same and depth placed, from feet to feet for each plug set.

- 3140' - 3090' Chat
- 3090 - 3060' Cement 6 sx
- 3060 - 200' Mud
- 200 - 185' Cement 15 sx
- 185 - 10' Mud
- 10 - 6' Cement 6 sx
- 6 - 0 Mud - to be put in cellar later.

PLUGGING  
FILE 21 20 2 104  
BOOK PAGE 143 LINE 17



(If additional description is necessary, use BACK of this sheet)

Correspondence regarding this well should be addressed to Victor Chancellor  
Address 1319 1/2 Main, Great Bend, Kans.

STATE OF Kansas, COUNTY OF Barton, ss.  
Victor Chancellor (employee of owner) or (owner or operator) of the above-described well,

being first duly sworn on oath, says: That I have knowledge of the facts, statements, and matters herein contained and the log of the above-described well as filed and that the same are true and correct. So help me God.

(Signature) Victor Chancellor

(Address)

SUBSCRIBED AND SWORN to before me this 24th day of July, 1941.

My commission expires 6-14-43

J. MacFarlane  
Notary Public.

WELL LOG

15.159.04492.0060

Sinclair Prairie Oil Company  
 L. A. Thompson # 7 (Seven)  
 E/2 - NW/4 Sec. 21-20S-10W  
 Rice County, Kansas

<u>Formation</u>	<u>Thickness</u>	<u>Total Depth</u>
Surface	0	137
Shell & Shale	137	995
Salt	995	1120
Broken Lima	1120	1340
Shale	1340	1350
Lime	1350	1380
Shale & Shells	1380	1660
Sandy Lime	1660	1738
Shale and Shells	1738	1930
Lime	1930	2049
Shale and Shells	2049	2100
Shale	2100	2165
Shale and Shells	2165	2215
Shale	2215	2286
Lime	2286	2395
Shale	2395	2408
Lime	2408	2470
Shale	2470	2508
Lime	2508	2537
Shale and Shells	2537	2583
Shale	2583	2600
Lime	2600	2630
Shale and Shells	2630	2660
Lime	2660	2675
Shale	2675	2689
Lime	2689	2780
Shale	2780	2799
Lime	2799	2895
Shale	2895	2903
Lime	2903	2928
Shale	2928	3015
Lime	3015	3309
Sand	3309	3315
Green Shale	3315	3323
Shale and Sand	3323	3341
Lime	3341	3343½' T. D.

Plugged back from 3343½' to 3140' with Lead wool and Cement.

Present Total Dept. 3140'

NO. 21 20S-10W  
 BLOCK 143 LRS-17

