

STATE OF KANSAS
STATE CORPORATION COMMISSION

Give All Information Completely
Make Required Affidavit
Mail or Deliver Report to:
Conservation Division
State Corporation Commission,
809 Bitting Building
Wichita, Kansas


WELL PLUGGING RECORD

OR

FORMATION PLUGGING RECORD

*pd.
6/9/38
ha*

6-9-38

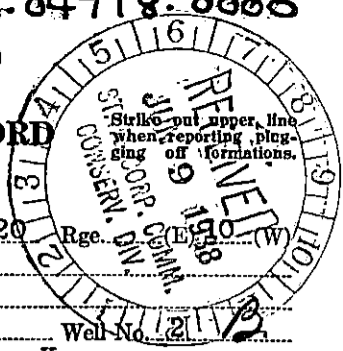

Rice County. Sec. 18 Twp. 20 Rge. (E) 10 (W)

Location as "NE 1/4 NW 1/4 SW 1/4" or footage from lines NW 1/4 NE 1/4 NE 1/4

Lease Owner Springrose Drilling Company

Lease Name Mantel B

Office Address 809 Ellis-Singleton Building, Wichita, Kansas

Character of Well (Completed as Oil, Gas or Dry Hole) Oil Well

Date, well completed March 16, 1938

Application for plugging filed May 24, 1938

Application for plugging approved May 24, 1938

Plugging Commenced May 24, 1938


Plugging Completed May 27, 1938

Reason for abandonment of well or producing formation Not commercial well

If a producing well is abandoned, date of last production May 15 1938

Was permission obtained from the Conservation Division or its agents before plugging was commenced?
Yes

NORTH

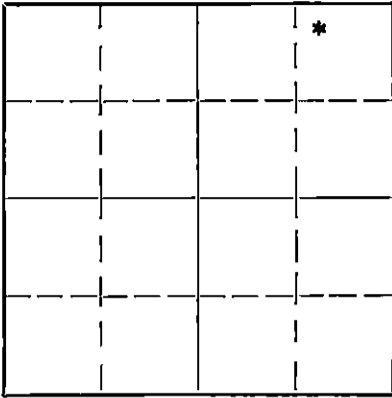

Locate well correctly on above Section Plat

Name of Conservation Agent who supervised plugging of this well Guy Wiershing

Producing formation Siliceous Lime Depth to top 3348 Bottom 3367 Total Depth of Well 3367 Feet

Show depth and thickness of all water, oil and gas formations.

OIL, GAS OR WATER RECORDS

CASING RECORD

Formation	Content	From	To	Size	Put In	Pulled Out
				8 5/8	3320	2137
				12 1/2	100	None

Describe in detail the manner in which the well was plugged, indicating where the mud fluid was placed and the method or methods used in introducing it into the hole. If cement or other plugs were used, state the character of same and depth placed, from 3367 feet to 3320 feet for each plug set.

Hole was plugged with cement from bottom, 3367 to 3320 feet. Hole was then filled to 3120 feet with mud before starting to pull casing. After pulling the casing the hole was filled up to 1800 feet with mud. Hole was bridged at 175 feet and cemented with 20 sacks of cement.

*pd.
6/9/38
ha*

PLUGGING
FILE SEC 18-T-20-R-104
BOOK PAGE 2 LINE 27

(If additional description is necessary use BACK of this sheet)

Correspondence regarding this well should be addressed to Springrose Drilling Company
Address 809 Ellis Singleton Building, Wichita, Kansas

STATE OF Kansas, COUNTY OF Sedgwick, ss.

(employee of owner) or (owner or operator) of the above-described well, being first duly sworn on oath, says: That I have knowledge of the facts, statements, and matters herein contained and the log of the above-described well as filed and that the same are true and correct. So help me God.

(Signature) *Sax Springer*

809 Ellis-Singleton Building, Wichita, Kansas
(Address)

SUBSCRIBED AND SWORN to before me this 4th day of June, 1938


My commission expires July 31, 1941

Att. Notary

Notary Public.


ROSE SPRING
Mantel No. *212*

SEC. 18 T. 20
NW NE NE

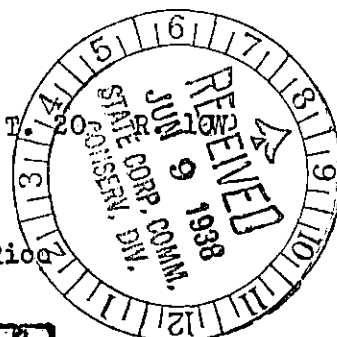

Total Depth. 3367' P.B. 3364'
Comm. 2-15-38 Comp. 3-14-38
Shot or Treated.
Contractor.
Issued. 5-14-38

County. Rice

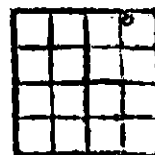

CASING:

12 1/2" 100'
8 1/4" 3324'

Elevation.

Production. Pot. 15 B.

Figures Indicate Bottom of Formations.

shale & red rock	480
shale & lime	615
shale & shells	835
shale & lime	1040
salt & shells	1135
shale & shells	1300
lime	1340
lime gyp shells	1375
lime	1420
lime brkn	1495
lime	1535
lime brkn	1610
sdv shale & lime shells	1700
lime & shale	1835
shale, sdv lime shells	1880
shale	1900
lime & shale	2000
shale	2055
lime & shale	2095
shale & lime shells	2375
lime	2420
brkn lime	2710
lime	2790
brkn lime	2815
lime	3040
brkn lime	3070
sh oil & gas 3185-3195	
lime	3289
shale	3295
shale & lime	3315
lime	3325
shale green	3337
conglomerate	3348
lime siliceous	3367
Total Depth.	

400' fluid in hole
11 BW, 8 BO
Made 1 1/2 BO in 1 1/2 hrs, 2/3 wtr.

P.B. 3364
Hole had 12 BW, 3 1/2 BO 40 hrs.

PLUGGING
FILE SEC. 18 T. 20 R. 10 W
BOOK PAGE 21 LINE 27