

15.159.04036.0000

STATE OF KANSAS
STATE CORPORATION COMMISSION


Form CP-4

WELL PLUGGING RECORD

Give All Information Completely
Make Required Affidavit
Mail or Deliver Report to:
Conservation Division
State Corporation Commission
P. O. Box 17027
Wichita, Kansas 67217
NORTH

Rice County, Sec. 18 Twp. 20 Rge. (E) 10 (W)

Location as "NE/CNW/SW" or footage from lines NW NW SE
Lease Owner K & D Oil Company
Lease Name Oberle Well No. 1
Office Address Box 27, Ellinwood, Kansas 67526
Character of Well (completed as Oil, Gas or Dry Hole) oil
Date well completed 19
Application for plugging filed July 15 19 76
Application for plugging approved 19
Plugging commenced July 20 19 76
Plugging completed July 22 19 76
Reason for abandonment of well or producing formation depleted

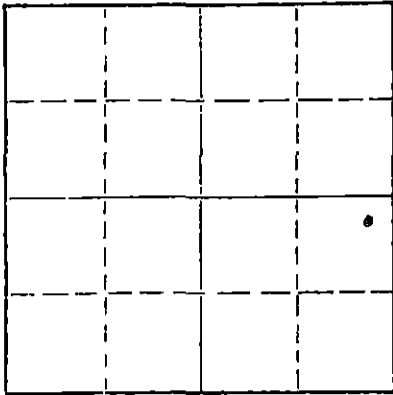

Locate well correctly on above Section Plat

If a producing well is abandoned, date of last production 19
Was permission obtained from the Conservation Division or its agents before plugging was commenced? yes

Name of Conservation Agent who supervised plugging of this well Gilbert Toman
Producing formation Depth to top Bottom Total Depth of Well 3272 Feet
Show depth and thickness of all water, oil and gas formations.

OIL, GAS OR WATER RECORDS

CASING RECORD

FORMATION	CONTENT	FROM	TO	SIZE	PUT IN	PULLED OUT
			157'	8 5/8"	157'	none
			3270'	5 1/2"	3270'	353.96

Describe in detail the manner in which the well was plugged, indicating where the mud fluid was placed and the method or methods used in introducing it into the hole. If cement or other plugs were used, state the character of same and depth placed, from feet to feet for each plug set.

Sanded back to 3200' and dumped 5 sacks of cement.

Allied Cementing Company plugged well pumping in 3 sacks of hulls, 20 sacks of gel and 85 sacks of cement.

7-28-76

(If additional description is necessary, use BACK of this sheet)
Name of Plugging Contractor PIPE PULLERS, INC.
Address Box 128, Ellinwood, Kansas 67526

STATE OF KANSAS, COUNTY OF BARTON, ss.
Evelyn Roth (employee of owner) or (owner or operator) of the above-described well, being first duly sworn on oath, says: That I have knowledge of the facts, statements, and matters herein contained and the log of the above-described well as filed and that the same are true and correct. So help me God.

(Signature) Evelyn Roth
Ellinwood, Kansas (Address)

SUBSCRIBED AND SWORN to before me this 26th day of July, 1976

My commission expires

JENNY KASSELMAN
NOTARY PUBLIC
BARTON COUNTY, KANSAS
MY COMM. EXP. JULY 16, 1978

Jenny Kasselmann
Notary Public.

STENCILED

ORIGINAL

MAY 1 1948

WELL LOG BUREAU KANSAS GEOLOGICAL SOCIETY

412 Union National Bk Bldg. Wichita, Kansas

15.159.04036.0000

(Ret. orig. w/1 copy 5-1-48)

Company WESTERN PETRO. EXP. CO.
Farm Katherine Oberle No.1

SEC. 18 T. 20 R. 10W
NW NW SE

Total Depth. 3275'

Comm. 1-17-48

Comp. 1-29-48


Shot or Treated.

Contractor. Mouser Drlg. Co.

Issued. 5-1-48

County. Rice

KANSAS

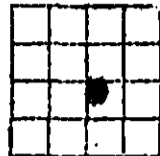

Elevation. _____

Production. Est. 500 Bbls.

Figures Indicate Bottom of Formations.

cellar	5
sand	35
shale blue	130
red bed	157
shale	170
red bed	450
anhydrite	470
red bed	520
shale & shells	925
salt	1210
shale & shells	1260
lime & shale	1625
flint	1650
lime & shale	2000
shale & shells	2500
lime & shale	2595
lime	2970
lime & shale	3010
lime	3266
conglomerate	3270
arbuckle	3275
Total Depth	

TOPS:	
Kansas City	3007
Arbuckle	3270

RECEIVED
STATE COMMISSION OF CONSERVATION

JUL 16 1948

CONSERVATION DIVISION
Wichita, Kansas