


STATE OF KANSAS
STATE CORPORATION COMMISSION

WELL PLUGGING RECORD

Give All Information Completely
Make Required Affidavit
Mail or Deliver Report to
Conservation Division
State Corporation Comm.
245 North Water
Wichita, KS 67202

Rice County, Sec. 18 Twp. 20 Rge. 10 E/W
Location as "NE/CNW/SW" or footage from lines
100' S W/2 W/2 NE/4
Lease Owner L. D. Davis/L. D. Drilling, Inc.
Lease Name PETERS Well No. 1
Office Address Rt #1, Box 183B, Great Bend, KS 67530
Character of Well (Completed as Oil, Gas or Dry Hole)
Dry Hole

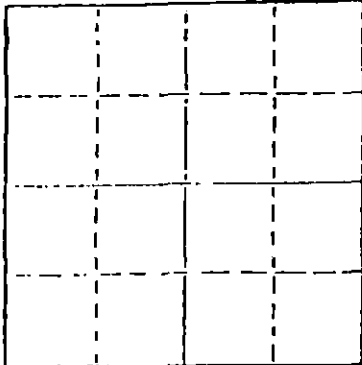

Locate well correctly on above Section Plat

Date Well completed January 16, 1984
Application for plugging filed January 17, 1984
Application for plugging approved January 16, 1984
Plugging commenced 8:30 A.M. January 16, 1984
Plugging completed 12:30 P.M. January 16, 1984
Reason for abandonment of well or producing formation
Dry Hole

If a producing well is abandoned, date of last production 19

Was permission obtained from the Conservation Division or its agents before plugging was commenced? yes

Name of Conservation Agent who supervised plugging of this well Gilbert Towman
Producing formation _____ Depth to top _____ Bottom _____ Total Depth of Well _____
Show depth and thickness of all water, oil and gas formations.

OIL, GAS OR WATER RECORDS

CASING RECORD

FORMATION	CONTENT	FROM	TO	SIZE	PUT IN	PULLED OUT

Describe in detail the manner in which the well was plugged, indicating where the mud fluid was placed and the method or methods used in introducing it into the hold. If cement or other plugs were used, state the character of same and depth placed, from _____ feet to _____ feet for each plug set.

30 SX @ 3290'
50 SX @ 360'
10 SX @ 40
10 SX in Rathole & Water Well

(If additional description is necessary, use BACK of this sheet)

Name of Plugging Contractor Halliburton

STATE OF KANSAS COUNTY OF BARTON, ss.
Don Popp (employee of owner) or ~~(owner/owner's representative)~~
of the above-described well, being first duly sworn on oath, says: That I have knowledge of the facts, statements, and matters herein contained and the log of the above-described well as filed and that the same are true and correct. So help me God.

(Signature) Don Popp
Don Popp, Hoisington, KS 67544
(Address)

SUBSCRIBED AND SWORN TO before me this 17th day of January, 1984

My commission expires 5-20-85
NOTARY PUBLIC - State of Kansas
BESSIE M. DeWERFF
My Appt. Exp. May 20, 1985
Bessie M. DeWerff Notary Public.

RECEIVED
STATE CORPORATION COMMISSION
JAN 20 1984
CONSERVATION DIVISION
Wichita, Kansas