

STATE OF KANSAS  
STATE CORPORATION COMMISSION

WELL PLUGGING RECORD


OR

FORMATION PLUGGING RECORD

Strike out upper line  
when reporting plug-  
ging off formations.

Give All Information Completely  
Make Required Affidavit  
Mail or Deliver Report to:  
Conservation Division  
State Corporation Commission  
800 Biting Building  
Wichita, Kansas

NORTH

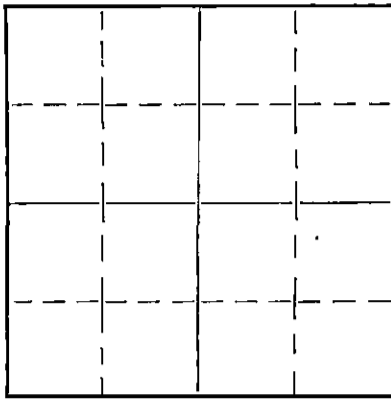

Locate well correctly on above  
Section Plat

Rice County. Sec. 21 Typ. 20S Rge. 10W (E) (W)  
Location as "NE 1/4 NW 1/4 SW 1/4" or footage from lines SW 1/4  
Lease Owner Producers Pipe & Supply Co.  
Lease Name W. M. Schurr Lease Well No. 6  
Office Address 609 Kennedy Building, Tulsa, Okla.  
Character of Well (Completed as Oil, Gas or Dry Hole)  
Date, well completed 193  
Application for plugging filed September 27, 1940 193  
Application for plugging approved September 28, 1940 193  
Plugging Commenced September 28, 1940 193  
Plugging Completed Sept. 30, 1940 193  
Reason for abandonment of well or producing formation Exhausted

If a producing well is abandoned, date of last production Don't know 193  
Was permission obtained from the Conservation Division or its agents before plugging was com-  
menced? Yes

Name of Conservation Agent who supervised plugging of this well Bill Morgan  
Producing formation Depth to top Bottom Total Depth of Well 3300 Feet.  
Show depth and thickness of all water, oil and gas formations.

OIL, GAS OR WATER RECORDS


CASING RECORD

Formation	Content	From	To	Size	Put In	Pulled Out
					3294'	2836'

Describe in detail the manner in which the well was plugged, indicating where the mud fluid was placed and the method or methods used in introducing it into the hole. If cement or other plugs were used, state the character of same and depth placed, from feet to feet for each plug set.

7" OD casing set at 3294'  
Cemented with 75 sacks  
20" casing cemented at 32'  
Run 4 sacks cement from 3300' to 3275'  
Filled with mud from 3275' to 2940'  
Run cement from 2940' to 2920'  
Filled with mud from 2920' to 200'  
Cemented from 200' to 185'  
Filled with mud from 185' to 6"  
Cemented from 6' to cellar base  
20" casing left in hole

10-17-40

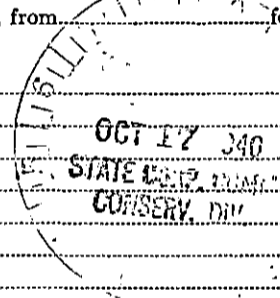

Plugging done by:  
General Oil Tool Company  
309 Beacon Building  
Wichita, Kansas

pd.  
10/17/40  
Ho,

PLUGGING  
FILE SEC 21 20 10W  
BOOK PAGE 17 LINE 9

(If additional description is necessary, use BACK of this sheet)

Correspondence regarding this well should be addressed to Producers Pipe & Supply Co.  
Address Box #1814 - Tulsa, Oklahoma

STATE OF OKLAHOMA, COUNTY OF TULSA, ss.  
Robert Green (employee of owner) or (owner or operator) of the above-described well,

being first duly sworn on oath, says: That I have knowledge of the facts, statements, and matters herein contained and the log of the above-described well as filed and that the same are true and correct. So help me God.

(Signature) Robert Green  
Box #1814 - Tulsa, Oklahoma  
(Address)

SUBSCRIBED AND SWORN to before me this 16th day of October 1940

My commission expires 6-7-43

Chris Jordan  
Notary Public.