

WELL PLUGGING RECORD

Give All Information Completely
Make Required Affidavit
Mail or Deliver Report to:
Conservation Division
State Corporation Commission
212 North Market, Insurance Bldg.
Wichita, Kansas

Rice County, Sec. 17 Twp. 20 Rge. 10 (E) W(W)

Location as "NE/CNW/SW" or footage from lines SE NE SE

Lease Owner Ben C. W. Hyde, Jr. and Wahline B. Storm-

Lease Name Rick Well No. 2 feltz

Office Address 4722 Broadway, Kansas City, Missouri

Character of Well (completed as Oil, Gas or Dry Hole) Oil

Date well completed March 22 1942

Application for plugging filed October 20, 1960

Application for plugging approved October 21, 1960


Plugging commenced November 3 1960

Plugging completed November 9 1960

Reason for abandonment of well or producing formation Reservoir depleted

If a producing well is abandoned, date of last production June 1960

Was permission obtained from the Conservation Division or its agents before plugging was commenced? Yes

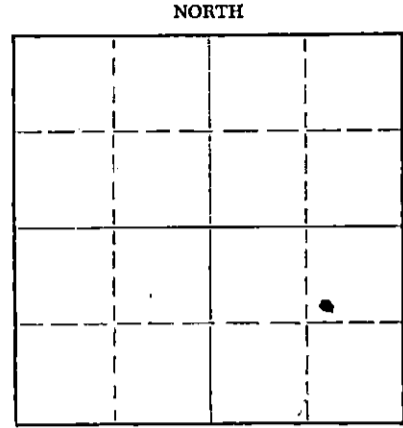

Locate well correctly on above Section Plat

Name of Conservation Agent who supervised plugging of this well C. J. Tolman

Producing formation Kansas City Depth to top _____ Bottom _____ Total Depth of Well 3122 Feet

Show depth and thickness of all water, oil and gas formations.

OIL, GAS OR WATER RECORDS

CASING RECORD

FORMATION	CONTENT	FROM	TO	SIZE	PUT IN	PULLED OUT
				10"	150'	None
				7"	3095'	2545'

Describe in detail the manner in which the well was plugged, indicating where the mud fluid was placed and the method or methods used in introducing it into the hole. If cement or other plugs were used, state the character of same and depth placed, from _____ feet to _____ feet for each plug set.

Plugged with sand to 3060'.
Dumped 6 sacks of cement.
Spotted 64 barrels of oil.
Pumped plug to 2400'.
Bailed hole to 200'.
Set 15' rock bridge.
Dumped 25 sks of cement.
Finished filling hole with mud to 25'.
10 Sacks of cement - capped well.

RECEIVED
CONSERVATION COMMISSION
DEC 21 1960
CONSERVATION DIVISION
Wichita, Kansas

(If additional description is necessary, use BACK of this sheet)

Name of Plugging Contractor Pipe Pullers, Inc. Permit #462

Address Box 486, Ellinwood, Kansas

STATE OF KANSAS, COUNTY OF BARTON, ss.
Dean Wells (employee of owner) or (~~owner or operator~~) of the above-described

well, being first duly sworn on oath, says: That I have knowledge of the facts, statements, and matters herein contained and the log of the above-described well as filed and that the same are true and correct. So help me God.

(Signature) Dean Wells

Box 486, Ellinwood, Kansas
(Address)

SUBSCRIBED AND SWORN to before me this 16th day of December, 1960

My commission expires July 7 - 1964

I. J. Rader
Notary Public.

C O P Y .

COMPANY: Hyde & Stormfeltz
 CONTRACTOR: C. C. Nelson Drilling Company
 FARM: Rick #2.
 LOCATION: Section 17-20-10
 Rice County, Kansas
 COMMENCED: March 2, 1942.
 COMPLETED: MARCH 22, 1942.

0	to	25	Surface Sand
25	to	35	Lime
35	to	163	Shale and shells
163	to	520	Red Bed and shells
520	to	820	Red Bed and Shale
820	to	1300	Shale and shells
1300	to	1370	Anhydrite
1370	to	1455	Lime
1455	to	1660	Shale and sand
1660	to	1715	Lime and shale
1715	to	1762	Lime
1762	to	1875	Shale and lime shells
1875	to	2400	Shale
2400	to	2430	Lime
2430	to	2630	Lime and shale
2630	to	2640	Lime
2640	to	2739	Lime and shale
2739	to	2884	Lime
2884	to	2970	Shale and lime
2970	to	3065	Shale
3065			Kansas City
3065	to	3095	Lime, broken. K. C.

Changed to Cardwell Tools

S. L. C.	3094	
3094	to	3102 Lime
3102	to	3110 Shale
3110	to	3122 Lime
3122	to	3126 Lime, more oil T. D.

RECEIVED
STATE CORPORATION COMMISSION

OCT 21 1960

CONSERVATION DIVISION
Wichita, Kansas

Set 150 feet 6 inches of 10 3/4 Surface Pipe. Cemented with 80 sacks cement.
 Set 3095 feet of 7" O. D.--20 pound casing. Cemented with 80 sacks cement

3122 to 3126 Lime and more oil
 300 feet oil in hole in one hour. 2500 feet oil in hole in six hours.
 Acidize with 5000 gallons acid.
 3126 Total Depth MAXIMUM WELL

C E R T I F I C A T E

I, C. C. Nelson, do hereby certify that the above and foregoing is a true and correct copy of log of the Rick #2 well, located in Section 17, Township 20 South, Range 10 West, Rice County, Kansas, as reflected by files of the C. C. Nelson Drilling Company.

(signed) C. C. Nelson

Subscribed and sworn to before me, a Notary Public, within and for Reno County, Kansas, this 26th day of March, 1942.

(signed) Margaret L. Holford
 Notary Public.

My commission expires Mar. 10, 1945.