


WELL PLUGGING RECORD

Give All Information Completely
Map as Required Affidavit
Mail or Deliver Report to:
Conservation Division
State Corporation Commission
800 Bittner Building
Wichita, Kansas

NORTH

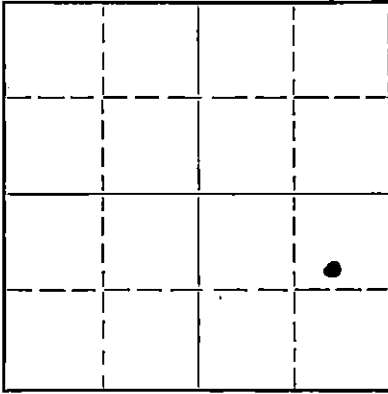

Locate well correctly on above
Section Plat

Rice County, Sec. 17 Twp. 20S Rge. (E) 10 (W)
Location as "NE/CNW $\frac{1}{4}$ SW $\frac{1}{4}$ " or footage from lines C S/2 NE SE
Lease Owner Hyde & Stormfeltz
Lease Name Karl Rick Well No. 3
Office Address 4638 J.C. Nichols Parkway, K.C. 2, Mo.
Character of Well (completed as Oil, Gas or Dry Hole) Oil
Date well completed February 3, 1944
Application for plugging filed November 1, 1951
Application for plugging approved November 3, 1951
Plugging commenced November 28, 1951
Plugging completed December 4, 1951
Reason for abandonment of well or producing formation
Gone Dry
If a producing well is abandoned, date of last production September 1951
Was permission obtained from the Conservation Division or its agents before plugging was commenced? Yes

Name of Conservation Agent who supervised plugging of this well Mr. M. A. Rives, Box 207, Great Bend, Kansas
Producing formation K.C. Lime Depth to top 3055 Bottom 3132 Total Depth of Well 3132 Feet
Show depth and thickness of all water, oil and gas formations.

OIL, GAS OR WATER RECORDS

CASING RECORD

Formation	Content	From	To	Size	Put In	Pulled Out
Sand		0	160	10"	160'	None
Shale and Lime		160	3132	7"	2819'	2116'
			3102"	5" Liner		None

Describe in detail the manner in which the well was plugged, indicating where the mud fluid was placed and the method or methods used in introducing it into the hole. If cement or other plugs were used, state the character of same and depth placed, from _____ feet to _____ feet for each plug set.

3132 to 3100 feet filled with sand
3100 to 3070 feet six sacks cement
3070 to 160 feet mudded
160 to 150 feet rock bridge
150 to 120 feet 20 sacks cement
120 to 20 feet mudded
20 feet to cellar 5 sacks cement

(If additional description is necessary, use BACK of this sheet)
Name of Plugging Contractor R & S Pipe Pulling Company, Box 192
Address Ellinwood, Kansas


STATE OF KANSAS, COUNTY OF JOHNSON, ss.
Ben C. W. Hyde, Jr., Co-owner (employee of owner) or (owner or operator) of the above-described well,
being first duly sworn on oath, says: That I have knowledge of the facts, statements, and matters herein contained and the log of the above-described well as filed and that the same are true and correct. So help me God.

(Signature) Ben C. W. Hyde, Jr.
4638 J.C. Nichols Parkway, K.C., Mo.
(Address)

SUBSCRIBED AND SWORN to before me this 23 day of January, 19 51.

Eunice J. Trapp
Notary Public.

My commission expires April 11, 1955.

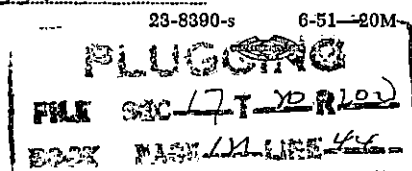

JAN 24 1952
CONSERVATION DIVISION
Wichita, Kansas

Hyde & Stormfeltz

No. 3 Rick - C S $\frac{1}{2}$ NE SE $\frac{1}{4}$ 17-20S-10W.,
Rice County, Kansas

Commenced: 12/1/43
Rotary Completion: 1/1/44
Cable Tool Completion: 2/3/44
Total Depth: 3132'
Contractor: Sharon Drilling Company, Inc.

El. 1798

Acid - 6000 Initial Potential 702 Bbls.

CASING RECORD

160 feet of 10" Surface Casing cemented with 100 sacks cement.
2819 feet of 7" O. D. Oil string casing cemented with 75 sacks cement.
5" Liner set to 3102 feet cemented with 125 sacks cement.

DRILLERS LOG

Sand	0' To	80'	Shale	2342'
Shale		124	Shale & Shells	2590
Shale & Shells		158	Sandy Shale	2640
Red Rick & Shale		200	Shale	2645
Red Rock		460	Lime	2928
Anhydrite		480	Shale	3055
Red Rock		1010	Lime (Rotary T. D.)	3102
Salt & Shale		1250	Lime (Total Depth)	3132'
Shale & Shells		1300		
Lime		1455		
Shale & Shells		1525		
Lime & Shale		1595		
Lime Broken		1670		
Sand & Lime		1710		
Shale		1770		
Sand & Lime		1805		
Shale		1875		
Broken Lime		2125		

GEOLOGICAL TOPS.

Topeka 2632
Lost circulation in Topeka at 2675,
2723, 2777 and 2793
Heelner shale 2894
Base Oread Lime 2927
Brown Lime 3020
Lansing Lime 3045
Trace of oil stain 3068 - 70
" " 3085 - 87
Show of free oil 3 to 4 gallons per hour
3115 - 3117
Fine oolitic granular porous lime,
oil pay zone 3124 - 28
1500' oil overnight at 3132
after 6000 acid well flowed 30 bbls. of oil
per hour.

STATE OF KANSAS)
COUNTY OF SEDGWICK)

ss.

RECEIVED
STATE CORPORATION COMMISSION

DEC - 8 1951

CONSERVATION DIVISION

D. S. Cates, being first duly sworn on oath, deposes and states that to the best of his knowledge and belief the foregoing log and geological data are true and correct.

SHARON DRILLING COMPANY, INC.,

By D. S. Cates

Subscribed and sworn to before me a Notary Public in and for the state and County aforesaid this 15th day of February 1944

My commission expires:

May 4 - 1947

PLUGGING
FILE SEC 17-20-10W
LOG PAGE 121

Emma Schidlawsky
Notary Public