


STATE OF KANSAS  
STATE CORPORATION COMMISSION

Give All Information Completely  
Make Required Affidavit  
Mail or Deliver Report to:  
Conservation Division  
State Corporation Commission  
800 Bittling Building  
Wichita, Kansas

WELL PLUGGING RECORD

NORTH

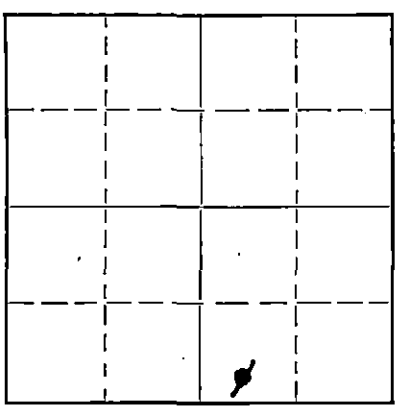

Locate well correctly on above  
Section Plat

Rice County. Sec. 17 Twp. 20 Rge. 10 (W)  
Location as "NE/CNW/4SW/4" or footage from lines C.S./2 SW SE  
Lease Owner Hyde & Stormfeltz  
Lease Name Carl Rick et al. Well No. 1  
Office Address 4638 J.C. Nichols Parkway, Kansas City 2, Mo.  
Character of Well (completed as Oil, Gas or Dry Hole) Old Oil Well Dry  
Date well completed February 1942  
Application for plugging filed November 1, 1951  
Application for plugging approved November 3, 1951  
Plugging commenced November 18, 1951  
Plugging completed November 27, 1951  
Reason for abandonment of well or producing formation Well went dry

If a producing well is abandoned, date of last production July, 1950  
Was permission obtained from the Conservation Division or its agents before plugging was commenced? Yes

Name of Conservation Agent who supervised plugging of this well Mr. M.A. Rives, Box 207, Great Bend, Kansas,  
Producing formation K.C. Lime Depth to top 3060' Bottom 3127' Total Depth of Well 3127' Feet  
Show depth and thickness of all water, oil and gas formations.

OIL, GAS OR WATER RECORDS

CASING RECORD

Formation	Content	From	To	Size	Put In	Pulled Out
Sand and Clay		Surface	1150'	8-5/8"	150'	None
Lime and Shale		1150'	3090'	5 1/2"	3090'	2188'

Describe in detail the manner in which the well was plugged, indicating where the mud fluid was placed and the method or methods used in introducing it into the hole. If cement or other plugs were used, state the character of same and depth placed, from 3127 feet to cellar feet for each plug set.

3127 to 3060 feet sand  
3060 to 3030 feet 6 sacks cement  
3030 to 150 feet mudded  
150 to 140 feet rock bridge  
140 to 120 feet 15 sacks cement  
120 to 15 feet mud  
15 to cellar 5 sacks cement

(If additional description is necessary, use BACK of this sheet)

Correspondence regarding this well should be addressed to Hyde & Stormfeltz  
Address 4638 J.C. Nichols Parkway, Room 215, Millcreek Bldg., K.C.2, Mo.

STATE OF KANSAS, COUNTY OF JOHNSON, ss.  
Ben C. W. Hyde, Jr. (owner or operator) of the above-described well,  
being first duly sworn on oath, says: That I have knowledge of the facts, statements, and matters herein contained and the log of the above-described well as filed and that the same are true and correct. So help me God.

(Signature) Ben C. W. Hyde, Jr.  
4638 J.C. Nichols Parkway, K.C.2, Mo.  
(Address)

SUBSCRIBED AND SWORN TO before me this 27 day of December, 1951.

Eunice O. Trapp  
Notary Public.

My commission expires April 11, 1955.

PLUGGING  
FILE SEC 17 TWP 20 RGE 10  
BOOK PAGE 17 LINE 3


12-28-51

HYDE & STORMFELTZ  
 Rick No. 1.

SEC. 17 T. 20 R. 10 W.  
 CSL SW SE

Total Depth. 3127  
 Comm. 1-22-42 Comp. 2- 1-42  
 Shot or Treated.  
 Contractor. C.C. Nelson Drilling Co.  
 Issued. 3-7-42

County Rice.

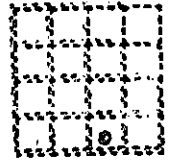

CASING.

85/8" 150' cemented  
 5 1/2" 3090'

Elevation.


Production. Pot. 16,000B  
 Bomb Test.

Figures Indicate Bottom of Formations.

sand	50	
surface clay	160	
red bed	400	
shale and lime	540	
shale and red shells	700	
red bed and shells	755	
anhydrite	790	
shale and shells	1065	
salt and shale	1250	
lime	1352	
lime and shale	1590	
sdv lime	1640	
lime and shale	1695	
sticky shale	1760	
lime and shale	1825	
shale	2080	
shale and shells	2210	
shale	2355	
lime	2420	
lime and shale	2660	
lime	2885	
shale	3034	
lime brown	3047	
shale	3060	
Kansas City lime	3077	
lime	3090	Rotary
shale blk	3095	
K.C. lime	3111	
K.C. lime soft	3118	
lime Oil pay	3127	
Total Depth.		

Oil from 3118-3123. 1000' fill up in one hour. Acidized 5000 gal  
 Potential 16,000 B. Bomb Test.

Top Lansing 3060

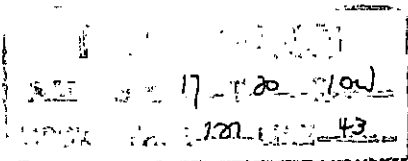

RECEIVED  
 STATE  
 DEC - 6 1951  
 COMMISSIONER'S DIVISION  
 Wichita, Kansas