


Give All Information Completely
Make Required Affidavit
Mail or Deliver Report to:
Conservation Division
State Corporation Commission
211 No. Broadway
Wichita, Kansas

WELL PLUGGING RECORD

Rice County, Sec. 17 Twp. 20S Rge. 10 (E) W (W)

Location as "NE/CNW%SW%" or footage from lines SW-SE-NE/4
Lease Owner Glickman Oil Company
Lease Name Poncin Well No. 1
Office Address 702 S. St. Francis, Wichita, Kansas
Character of Well (completed as Oil, Gas or Dry Hole) Dry Hole
Date well completed May 21 1965
Application for plugging filed May 21 1965
Application for plugging approved May 21 1965
Plugging commenced May 21 1965
Plugging completed May 21 1965 =
Reason for abandonment of well or producing formation

NORTH

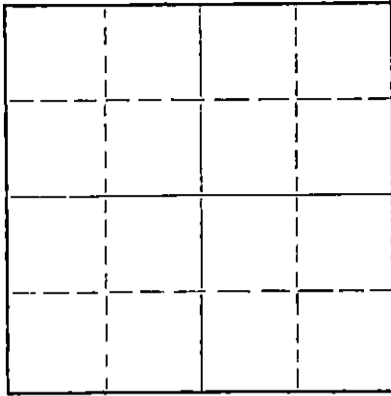

Locate well correctly on above Section Plat

If a producing well is abandoned, date of last production 19
Was permission obtained from the Conservation Division or its agents before plugging was commenced? Yes

Name of Conservation Agent who supervised plugging of this well Gilbert Toman
Producing formation Depth to top Bottom Total Depth of Well 3385' Feet
Show depth and thickness of all water, oil and gas formations.

OIL, GAS OR WATER RECORDS

CASING RECORD

FORMATION	CONTENT	FROM	TO	SIZE	PUT IN	PULLED OUT
				10-3/4	229'	None

Describe in detail the manner in which the well was plugged, indicating where the mud fluid was placed and the method or methods used in introducing it into the hole. If cement or other plugs were used, state the character of same and depth placed, from feet to feet for each plug set.
Mud hole up to 220' set plug and 1/4 sx., 25 sx. cement through drill pipe. Mud up to 40' set plug and hulls, cement with 15 sx. - 2 in rat hole.

RECEIVED
STATE CORPORATION COMMISSION

JUN 11 1965

CONSERVATION DIVISION
Wichita, Kansas

(If additional description is necessary, use BACK of this sheet)

Name of Plugging Contractor Glickman Oil Company
Address 702 S. St. Francis, Wichita, Kansas

STATE OF Kansas, COUNTY OF Sedgwick, ss.
Milton Glickman (employee of owner) or (owner or operator) of the above-described well, being first duly sworn on oath, says: That I have knowledge of the facts, statements, and matters herein contained and the log of the above-described well as filed and that the same are true and correct. So help me God.

(Signature) *Milton Glickman*
Milton Glickman
702 S. St. Francis, Wichita, Kansas
(Address)

SUBSCRIBED AND SWORN to before me this 10th day of June, 1965

My commission expires November 19, 1967
Loirella Schauf Notary Public.

15.159.30070.00.00

GLICKMAN OIL COMPANY

P.O. Box 3104

Wichita, Kansas 67211

DRILLERS WELL LOG

Company: Glickman Oil Company

Location: SW-SE-NE 1/4

17-20S-10W

Farm: Poncin

Well No. 1

Rice County, Kansas

Commenced: 5-13-65

Elevation: 1824 K.B.

Completed: 5-21-65

Total Depth: 3385'

Geologist: Bob Brooks

Casing: 10-3/4" set @ 229' cemented w/165' sxs

Production: D & A

Figures Indicate Bottom of Formations

65'	Sand & Clay
229'	Clay, Shale & Shells
1041'	Shale & Shells
1390'	Shale & Lime
1745'	Lime & Shale
1950'	Shale & Lime
2460'	Lime & Shale
2640'	Shale & Lime
2829'	Lime & Shale
2910'	Lime
3120'	Lime & Shale
3385'	Lime
3385'	Total Depth

TOPS

Topeka	2661'
Heebner	2934'
Brown Lime	3060'
Lansing-K.C.	3086'
Conglomerate	3375'

RECEIVED
STATE CORPORATION COMMISSION

JUN 11 1965

CONSERVATION DIVISION
Wichita, Kansas

STATE OF KANSAS, COUNTY OF SEDGWICK, ss:

I, Milton Glickman, of the Glickman Oil Company, upon oath state that the above and foregoing is a true and correct copy of the log of the Poncin #1

Milton Glickman

Subscribed and sworn to before me this 10th day of June, 1965

Lorella Schauf

Notary Public

My Commission Expires: November 19, 1967