

CARD MUST BE TYPED

State of Kansas
NOTICE OF INTENTION TO DRILL
(see rules on reverse side)

CARD MUST BE SIGNED

Starting Date: 10-01-84
month day year

API Number 15- 153-20,578-00-00

OPERATOR: License # 9158
Name Case Oil & Gas
Address Box 341
City/State/Zip Pratt, KS 67124
Contact Person Stan Case
Phone (316) 672-2221

C-11/2-E1/2 NE Sec 14 Twp 1 S, Rge 34 East
(location) West

3960 Ft North from Southeast Corner of Section
330 Ft West from Southeast Corner of Section
(Note: Locate well on Section Plat on reverse side)

CONTRACTOR: License # 5143
Name Buffalo Drilling
City/State Wichita, KS

Nearest lease or unit boundary line 330 feet.
County Rawlins
Lease Name BUDA Well# 1

Well Drilled For: Well Class: Type Equipment:
 Oil Swd Infield Mud Rotary
 Gas Inj Pool Ext. Air Rotary
 OWWO Expl Wildcat Cable

Domestic well within 330 feet: yes no
Municipal well within one mile: yes no

Depth to Bottom of fresh water 250 feet
Lowest usable water formation 100 Unconsolidated
Depth to Bottom of usable water 100-300 feet
Surface pipe by Alternate: 1 2
Surface pipe to be set 300 feet
Conductor pipe if any required _____ feet
Ground surface elevation _____ feet MSL
This Authorization Expires 3-19-85
Approved By 9-19-84 KA

If OWWO: old well info as follows:

Operator _____
Well Name _____
Comp Date _____ Old Total Depth _____
Projected Total Depth 4500 feet
Projected Formation at TD Mississippi
Expected Producing Formations Lansing

I certify that we will comply with K.S.A. 55-101, et seq., plus eventually plugging hole to K.C.C. specifications.

Date 9-1-84 Signature of Operator or Agent

Stan Case

Title partner

MHC/MOHE 9/19/84


Must be filed with the K.C.C. five (5) days prior to commencing well
 This card void if drilling not started within six (6) months of date received by K.C.C.

SEP 19 1984

Important procedures to follow:

A Regular Section of Land
 1 Mile = 5,280 Ft.

O-Location

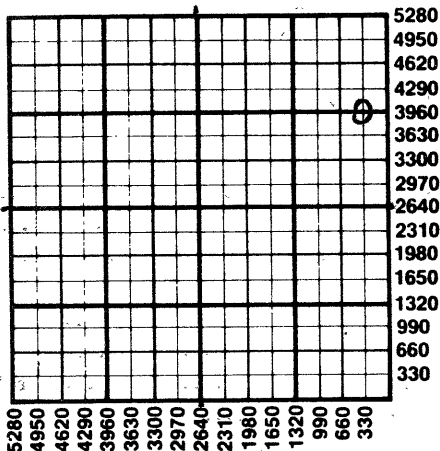

1. Notify District office before setting surface casing.
2. Set surface casing by circulating cement to the top.
3. File completion forms ACO-1 with K.C.C. within 90 days of well completion, following instructions on ACO-1, side 1, and including copies of wireline logs.
4. Notify District office 48 hours prior to old well workover or re-entry.
5. Prior to plugging, prepare a plugging plan, then obtain agreement from the appropriate district office for an approved plugging plan.
6. Submit plugging report (CP-4) to K.C.C. after plugging is completed.
7. Obtain an approved injection docket number before disposing of salt water.
8. Notify K.C.C. within 10 days when injection commences or terminates.
9. If an alternate 2 completion, cement in the production pipe from below any usable water to surface within 120 days of spud date.

State Corporation Commission of Kansas
 Conservation Division
 200 Colorado Derby Building
 Wichita, Kansas 67202
 (316) 263-3238

RECEIVED
 STATE CORPORATION COMMISSION
 Conservation Division
 Wichita, Kansas
 8-17-84
 AUG 17 1984