

CARD MUST BE TYPED

State of Kansas

CARD MUST BE SIGNED

NOTICE OF INTENTION TO DRILL

(see rules on reverse side)

✓ DA

Starting Date 1 5 89
month day year

API Number 15- 153 - 20,731 - 00 - 00

OPERATOR: License # 5131
Name Thunderbird Drilling, Inc.
Address P.O. Box 780407
City/State/Zip Wichita, KS 67278
Contact Person Burke B. Krueger
Phone (316) 685-1441

C SE SE Sec. 25 Twp. 1 S, Rg. 34 East
660 Ft. from South Line of Section
660 Ft. from East Line of Section

(Note: Locate well on Section Plat on reverse side)

CONTRACTOR: License # 5422
Name Abercrombie Drilling, Inc.
City/State Wichita, Kansas

Nearest lease or unit boundary line 660 feet
County Rawlins
Lease Name Horinek "B" Well # 1

Well Drilled For: Well Class: Type Equipment:
 Oil SWD Infield Mud Rotary
 Gas Inj Pool Ext. Air Rotary
 OWWO Expl Wildcat Cable

Ground surface elevation 3060 feet MSL
Domestic well within 330 feet: yes no
Municipal well within one mile: yes no
Surface pipe by Alternate: 1 2

If OWWO: old well info as follows:

Operator
Well Name
Comp Date Old Total Depth

Depth to bottom of fresh water 150
Depth to bottom of usable water ~~150~~ 200
Surface pipe planned to be set 280
Projected Total Depth 4300' feet
Formation Lansing-Kansas City

I certify that well will comply with K.S.A. 55-101, et seq., plus eventually plugging hole to KCC specifications.

cementing will be done immediately upon setting production casing.

Date 12/21/88 Signature of Operator or Agent Title Land Mgr.

For KCC Use: **EFFECTIVE DATE: 12-27-88**
Conductor Pipe Required feet; Minimum Surface Pipe Required 250' feet per Alt. 1 2


This Authorization Expires 6-22-89 Approved By LKM 12-22-88

Must be filed with the K.C.C. five (5) days prior to commencing well
 This card void if drilling not started within six (6) months of date received by K.C.C.

Important procedures to follow:

1. Notify District office before setting surface casing.
2. Set surface casing by circulating cement to the top.
3. File completion forms ACO-1 with K.C.C. within 90 days of well completion, following instructions on ACO-1, side 1, and including copies of wireline logs.
4. Notify District office 48 hours prior to old well workover or re-entry.
5. Prior to filing Intent, prepare a proposed plugging plan in case well is D & A, then obtain approval of plan when calling district office prior to setting surface pipe.
6. Submit plugging report (CP-4) to K.C.C. after plugging is completed.
7. Obtain an approved injection docket number before disposing of salt water.
8. Notify K.C.C. within 10 days when injection commences or terminates.
9. If an alternate 2 completion, cement in the production pipe from below any usable water to surface within 120 days of spud date.

**A Regular Section of Land
 1 Mile = 5,280 Ft.**

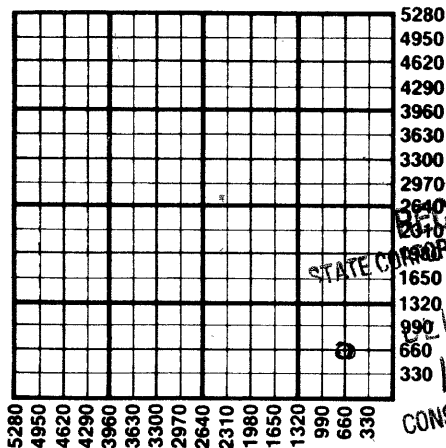

RECEIVED
 STATE CORPORATION COMMISSION
 DEC 22 1988
 12-22-88
 CONSERVATION DIVISION
 Wichita, Kansas

State Corporation Commission of Kansas
 Conservation Division
 200 Colorado Derby Building
 Wichita, Kansas 67202
 (316) 263-3238