

Amended

SIDE ONE

STATE CORPORATION COMMISSION OF KANSAS  
OIL & GAS CONSERVATION DIVISION  
WELL COMPLETION OR RECOMPLETION FORM  
ACO-1 WELL HISTORY  
DESCRIPTION OF WELL AND LEASE

Operator: License # ... 5140  
Name Frontier Oil Company  
Address 125 N. Market, Ste. 1720  
City/State/Zip Wichita, Kansas 67202

Purchaser N/A

Operator Contact Person Jean Angle  
Phone 316-263-1201

Contractor: License # 5302  
Name Frontier Oil Company  
Red Tiger Drilling Co.

Wellsite Geologist Richard D. Barker  
Phone 913-483-5348

Designate Type of Completion  
 New Well  Re-Entry  Workover

Oil  SWD  Temp Abd  
 Gas  Inj  Delayed Comp.  
 Dry  Other (Core, Water Supply etc.)

If ONWO: old well info as follows:  
Operator  
Well Name  
Comp. Date Old Total Depth

WELL HISTORY


Drilling Method:  
 Mud Rotary  Air Rotary  Cable  
12-9-88 12-16-88 12-17-88  
Spud Date Date Reached TD Completion Date  
4313 N/A  
Total Depth PBTD

Amount of Surface Pipe Set and Cemented at 274 feet  
Multiple Stage Cementing Collar Used?  Yes  No  
If yes, show depth set feet  
If alternate 2 completion, cement circulated from feet depth to w/ SX cmt  
Cement Company Name  
Invoice #  
NITZ OYA

API NO. 15-153-20,729-00-00  
County Rawlins  
C. SW. NE Sec. 34 Twp. 1 Rge. 24W East  
3300 Ft North from Southeast Corner of Section  
1800 Ft West from Southeast Corner of Section  
(Note: Locate well in section plat below)

Lease Name Ruda Well # 1  
Field Name WC  
Producing Formation N/A  
Elevation: Ground 3082 KB 3087

Section Plat

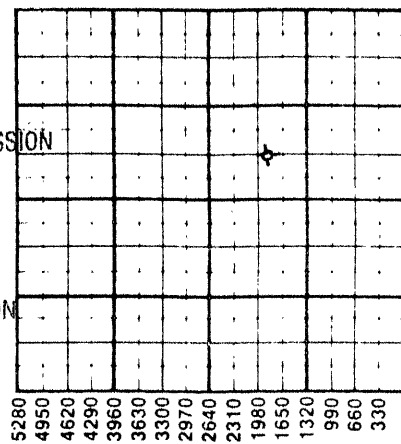

RECEIVED  
01-17-1989  
JAN 17 1989  
STATE CORPORATION COMMISSION  
CONSERVATION DIVISION  
Wichita, Kansas

WATER SUPPLY INFORMATION

Disposition of Produced Water:  Disposal  
Docket #  Repressuring

Questions on this portion of the ACO-1 call:  
Water Resources Board (913) 296-3717

Source of Water:  
Division of Water Resources Permit #  
Groundwater Ft North from Southeast Corner (Well) Ft West from Southeast Corner of Sec Twp Rge East West  
 Surface Water 2500 Ft North from Southeast Corner 300 Ft West from Southeast Corner Sec 34 Twp 1S Rge 34W East West  
Edgar Skolout, RFD 2, Atwood, Kansas 67730  
Other (explain)  
(purchased from city, R.W.D. #)

INSTRUCTIONS: This form shall be completed in triplicate and filed with the Kansas Corporation Commission, 200 Colorado Derby Building, Wichita, Kansas 67202, within 120 days of the spud date of any well. Rule 82-3-130, 82-3-107 and 82-3-106 apply. Information on side two of this form will be held confidential for a period of 12 months if requested in writing and submitted with the form. See rule 82-3-107 for confidentiality in excess of 12 months. One copy of all wireline logs and drillers time log shall be attached with this form. Submit CP-4 form with all plugged wells. Submit CP-111 form with all temporarily abandoned wells.

All requirements of the statutes, rules and regulations promulgated to regulate the oil and gas industry have been fully complied with and the statements herein are complete and correct to the best of my knowledge.

Signature Jean Angle  
Title Agent Date

Subscribed and sworn to before me this 19 day of Notary Public D. Ann Drennan

Date Commission Expires 2-10-90  
D'ANN DRENNAN  
NOTARY PUBLIC  
STATE OF KANSAS  
My Appt. Exp.

K.C.C. OFFICE USE ONLY  
 Letter of Confidentiality Attached  
 Wireline Log Received  
 Drillers Timelog Received  
Distribution  
 KCC  SWD/Rep  NGPA  
 KGS  Plug  Other (Specify)  
1-17-89  
Form ACO-1 (5-86)

Sec. 34 Twp. 1. Rge. 34W