

Rec'd 1-15-85
CARD MUST BE TYPED

State of Kansas
NOTICE OF INTENTION TO DRILL
(see rules on reverse side)

CARD MUST BE SIGNED

Starting Date: January 28, 1985
month day year

API Number 15- 153-20,591-00-00

OPERATOR: License # 5447
Name Cities Service Oil & Gas Corporation
Address 209 E. William, 700 Sutton Place Bldg.
City/State/Zip Wichita, Kansas 67202
Contact Person Charles W. Horsman
Phone 316 265-5624

NW .NW .NW. Sec 24 Twp 1 S, Rge 35
(location) East West

4950 Ft North from Southeast Corner of Section
4950 Ft West from Southeast Corner of Section
(Note: Locate well on Section Plat on reverse side)

CONTRACTOR: License # 5302
Name Red Tiger Drilling Company
City/State Wichita, Kansas 67202

Nearest lease or unit boundary line 330 feet.
County Rawlins
Lease Name Sis 'A' Well# 1

Well Drilled For: Well Class: Type Equipment:
 Oil Swd Infield Mud Rotary
 Gas Inj Pool Ext. Air Rotary
 OWWO Expl Wildcat Cable

Domestic well within 330 feet: yes no
Municipal well within one mile: yes no

If OWWO: old well info as follows:
Operator
Well Name
Comp Date Old Total Depth
Projected Total Depth 4650 feet
Projected Formation at TD Marmaton
Expected Producing Formations Lansing-Kansas City

Depth to Bottom of fresh water 250 feet
Lowest usable water formation Unconsolidatedes
Depth to Bottom of usable water 300 feet
Surface pipe by Alternate: 1 2
Surface pipe to be set 300 ~~300~~ 300 feet
Conductor pipe if any required None feet
Ground surface elevation 3140 feet MSL
This Authorization Expires 7-15-85
Approved By 1-15-85 R

I certify that we will comply with K.S.A. 55-101, et seq., plus eventually plugging hole to K.C.C. specifications.

Date 1/15/85 Signature of Operator or Agent

Charles W. Horsman Title Engineer
Charles W. Horsman

MHC/UNOHE 1-15-85

Must be filed with the K.C.C. five (5) days prior to commencing well
 card void if drilling not started within six (6) months of date received by K.C.C.

CONSERVATION DIVISION
 Wichita, Kansas


58-51-1

JAN 15 1985

A Regular Section of
 1 MINUTE 200 Ft.

Important procedures to follow :

1. Notify District office before setting surface casing.
2. Set surface casing by circulating cement to the top.
3. File completion forms ACO-1 with K.C.C. within 90 days of well completion, following instructions on ACO-1, side 1, and including copies of wireline logs.
4. Notify District office 48 hours prior to old well workover or re-entry.
5. Prior to plugging, prepare a plugging plan, then obtain agreement from the appropriate district office for an approved plugging plan.
6. Submit plugging report (CP-4) to K.C.C. after plugging is completed.
7. Obtain an approved injection docket number before disposing of salt water.
8. Notify K.C.C. within 10 days when injection commences or terminates.
9. If an alternate 2 completion, cement in the production pipe from below any usable water to surface within 120 days of spud date.

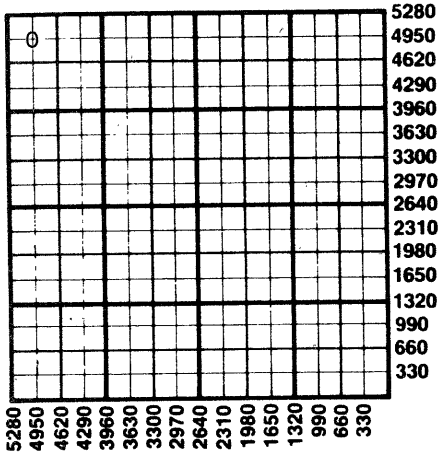

**State Corporation Commission of Kansas
 Conservation Division
 200 Colorado Derby Building
 Wichita, Kansas 67202
 (316) 263-3238**