


15-153-20248-00-00

STATE OF KANSAS
STATE CORPORATION COMMISSION
CONSERVATION DIVISION
P. O. BOX 17027
WICHITA, KANSAS 67217

WELL PLUGGING RECORD

Rawlins County, Sec 11 Twp. 1S Rge. 35 XX (W)

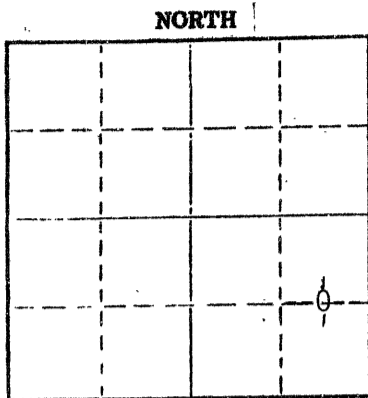

Locate well correctly on above Section Plat

Location as "NE/CNW/SW" or footage from lines 660' ESL 330' FEL
Lease Owner Gemini Corporation
Lease Name Sis Well No. 1
Office Address P.O. Box 818, McCook, Nebraska 69001
Character of Well (completed as Oil, Gas or Dry Hole) dry hole
Date well completed 4-28 1976
Application for plugging filed 4-28 1976
Application for plugging approved 4-28 (verbal) 1976
Plugging commenced 4-28 1976
Plugging completed 4-28 1976

Reason for abandonment of well or producing formation commercial quantities of oil not found

If a producing well is abandoned, date of last production 19
Was permission obtained from the Conservation Division or its agents before plugging was commenced? Yes

Name of Conservation Agent who supervised plugging of this well Gilbert Balthazor - Palco, Kansas
Producing formation _____ Depth to top _____ Bottom _____ Total Depth of Well 4350 Feet
Show depth and thickness of all water, oil and gas formations.

OIL, GAS OR WATER RECORDS

CASING RECORD

FORMATION	CONTENT	FROM	TO	SIZE	PUT IN	PULLED OUT
				8 5/8"	278	None

Describe in detail the manner in which the well was plugged, indicating where the mud fluid was placed and the method or methods used in introducing it into the hole. If cement or other plugs were used, state the character of same and depth placed, from _____ feet to _____ feet for each plug set.

Drilling mud (10 ppg) from 1900' to 4350'
Cement - 70 sacks from 1690 to 1900'
Drilling mud (10 ppg) from 270' to 1690'
Cement - 20 sacks from 210' to 270'
Drilling mud (10 ppg) from 40' to 210'
Cement - 10 sacks from 5' to 40'
Cemented rat hole
Mud and cement placed through drill pipe

115-03-1976
05-03-1976
CONSERVATION DIVISION
WICHITA, KANSAS

(If additional description is necessary, use BACK of this sheet)


Name of Plugging Contractor Halliburton Services
Address P.O. Box 339, Hays, Kansas 67601

STATE OF NEBRASKA COUNTY OF RED WILLOW, ss.
M. E. Carr (Employer/Owner) or (owner or operator) of the above-described well, being first duly sworn on oath, says: That I have knowledge of the facts, statements, and matters herein contained and the log of the above-described well as filed and that the same are true and correct. So help me God.

(Signature) *M. Carr*
P.O. Box 818, McCook, Nebraska 69001
(Address)

SUBSCRIBED AND SWORN TO before me this 28th day of April 1976

My commission expires

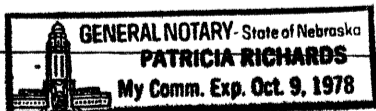

Notary Public