


WELL PLUGGING RECORD

Give All Information Completely
Make Required Affidavit
Mail or Deliver Report to:
Conservation Division
State Corporation Commission
211 No. Broadway
Wichita, Kansas

NORTH

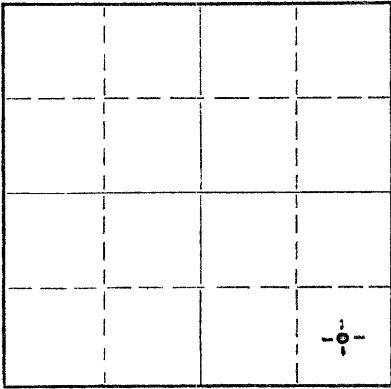

Locate well correctly on above
Section Plat

Rawlins County. Sec. ²⁷ 26 Twp. 1S Rge. (E) 35 (W)

Location as "NE/CNW/SW" or footage from lines 600' FSL & 630' FEL, SESE

Lease Owner Pubco Petroleum Corporation

Lease Name Cahoj Well No. 27-16

Office Address P.O. Box 432, McCook, Nebraska

Character of Well (completed as Oil, Gas or Dry Hole) Dry Hole

Date well completed July 9 19 65

Application for plugging filed July 12 19 65

Application for plugging approved July 13 19 65

Plugging commenced July 9 19 65

Plugging completed July 9 19 65

Reason for abandonment of well or producing formation Non-productive

If a producing well is abandoned, date of last production 19

Was permission obtained from the Conservation Division or its agents before plugging was commenced? Yes

Name of Conservation Agent who supervised plugging of this well W. L. Nichols

Producing formation Depth to top Bottom Total Depth of Well 4755 Feet

Show depth and thickness of all water, oil and gas formations.

OIL, GAS OR WATER RECORDS

CASING RECORD

FORMATION	CONTENT	FROM	TO	SIZE	PUT IN	PULLED OUT
				8 5/8" 22#	208'	None

Describe in detail the manner in which the well was plugged, indicating where the mud fluid was placed and the method or methods used in introducing it into the hole. If cement or other plugs were used, state the character of same and depth placed, from feet to feet for each plug set.

Drilling mud from 600' to 4755'
20 sack cement plug from 530' to 600'
Drilling mud from 200' to 530'
20 sack cement plug from 130' to 200'
Drilling mud from 40' to 130'
10 sack cement plug from 5' to 40'

RECEIVED
STATE CORPORATION COMMISSION

JUL 29 1965

7-29-65

Well plugged through drill pipe.

CONSERVATION DIVISION
Wichita, Kansas

(If additional description is necessary, use BACK of this sheet)

Name of Plugging Contractor Burch Exploration, Inc.
Address 1011 Union Center, Wichita, Kansas

STATE OF Nebraska, COUNTY OF Red Willow, ss.
I, Michael E. Garr.

(employee of owner) or (owner) of the above-described well, being first duly sworn on oath, says: That I have knowledge of the facts, statements, and matters herein contained and the log of the above-described well as filed and that the same are true and correct. So help me God.

(Signature) Michael E. Garr

P.O. Box 432, McCook, Nebraska
(Address)

SUBSCRIBED AND SWORN TO before me this 27th day of July, 19 65

My commission expires June 29, 1971

Annafed Fugler
Notary Public.

WELL LOG

15-153-30103-00-00

COMPANY: Pubco Petroleum Corporation

CONTRACTOR: Burch Exploration, Inc.

FARM: Cahoj #27-16

LOCATION: 600' FSL and 630' FEL, Sec. ²⁷⁻¹⁻³⁵~~26~~1S-35W, Rawlins County, Kansas

COMMENCED: June 26, 1965 ELEVATION: 3115' G.L.
3120' K.B.

COMPLETED: July 9, 1965 POTENTIAL: D & A

SURFACE CASING: Set 8 5/8" 22# new casing at 208' cemented with 225 sacks of 50:50 Pozmix w/2% gel and 2% calcium chloride. Circulated cement to surface.

PLUGGING RECORD: Spotted 20 sack plug at 600', and 20 sack plug at 200' and 10 sack plug at 40'. Finished plugging at 2:30 p.m. 7-9-65.

0	to	175	Surface Soil-Sand
175	to	955	Shale
955	to	2215	Shale & Sand
2215	to	2805	Shale & Lime
2805	to	2819	Anhydrite
2819	to	2976	Shale & Sand
2976	to	3012	Anhydrite
3012	to	3855	Shale & Lime
3855	to	4087	Lime & Shale
4087	to	4170	Shale & Lime
4170	to	4310	Lime & Shale
4310	to	4374	Shale & Lime
4374	to	4681	Lime & Shale
4681	to	4715	Shale & Lime
4715	to	4743	Lime & Shale
4743	to	4755	Lime & Chert
			Rotary Total Depth

RECEIVED
STATE CORPORATION COMMISSION

JUL 29 1965
7-29-65
CONSERVATION DIVISION
Wichita, Kansas

SCHLUMBERGER ELECTRIC LOG TOPS:

Topeka	3821	-701
Deer Creek	3893	-773
Oread	3948	-828
Lansing	4054	-934
Base Kansas City	4314	-1194
Cherokee	4486	-1366
Mississippian	4705	-1585
Schlumberger T.D.	4758	-1638
